

# GRANT COUNTY

## Survey Monument Record

TYPE OF MONUMENT 3/4" X 24" IRON BAR SET

STATE PLANE COORDINATES: N \_\_\_\_\_  
E \_\_\_\_\_

ELEVATION — M.S.L. DATUM: \_\_\_\_\_

THETA ANGLE: \_\_\_\_\_

FIELD BOOK: 94-18

PAGE \_\_\_\_\_

CORNER NO. \_\_\_\_\_


SECTION 21

TOWN 2N

RANGE 1W

### BASIS FOR MONUMENT LOCATION


(Use reverse side if necessary)

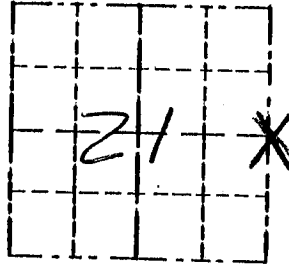

LOCATION  
(Indicated by "X")

CORNER SET IN 1832 BY LUCIUS LYON. ORIGINAL BEARING TREES WERE UNRECOVERABLE. ONLY SEAL:

RECORD FOUND WAS A HIGHWAY MAP FOR C.T.H. "D". CORNER SET PER PLAT OF RIGHT OF WAY PROJ. I.D. # 5930-2-21 SHEET 4/5. VERIFIED ITS LOCATION USING EDM METHODS.

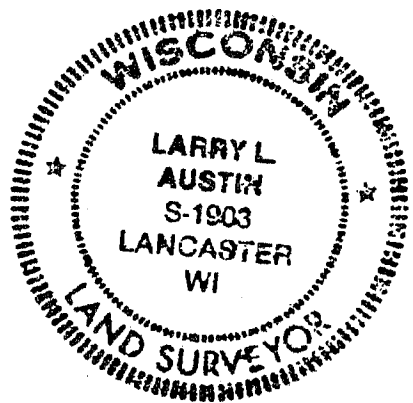

CERTIFIED CORRECT

*Larry L. Austin*  
Registered Land Surveyor

DATE: 10/8/96

### TIE SKETCH

Show at least three (3) ties and monument

#### LEGEND

⊕ 3/4" X 24" IRON BAR SET

○ 1/2" X 18" IRON BAR SET

XX EXISTING FENCE

CENTERLINE

