


GRANT COUNTY

Survey Monument Record

TYPE OF MONUMENT 3/4" BAR
 STATE PLANE COORDINATES: N _____
 E _____
 ELEVATION — M.S.L. DATUM: _____
 THETA ANGLE: _____
 FIELD BOOK: 93-07
 PAGE 5

CORNER NO. 107
 SECTION 27
 TOWN 2 N
 RANGE 1 W

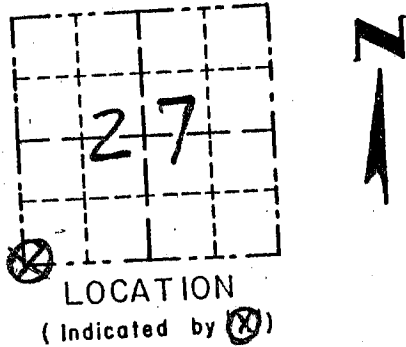


BASIS FOR MONUMENT LOCATION

(Use reverse side if necessary)

Show info such as: History of corner, with reference to Vol. and pg., dates, surveyor; exact description of monument replaced; if location computed, by taped or EDM traverse; landowner, remarks, etc.

CORNER WAS FOUND 3/4" BAR
 LOCATION CORRESPONDS TO LAST
 AVAIL RECORD C.T.H. "D" PLAN
 RS 0207 (5). LOCATION VERIFIED
 BY EDM TRAVERSE OF THE AREA.

SEAL:

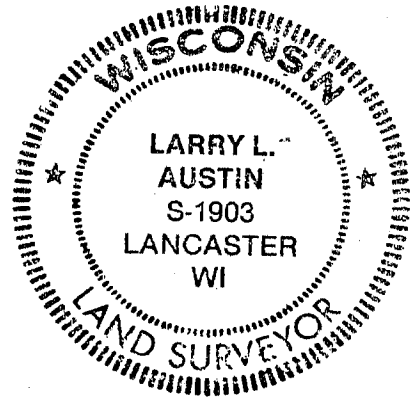

CERTIFIED CORRECT

Larry L. Austin
 Registered Land Surveyor
 DATE: 7/20/93

TIE SKETCH

Show at least three (3) ties and monument
 SCALE 1" = 100'

LEGEND

- 3/4" SOLID ROUND BAR FOUND
- 3/8" x 24" IRON BARS SET AS TIES - Next to R/W POSTS

