

GRANT COUNTY

Survey Monument Record

TYPE OF MONUMENT COUNTY ALUMINUM MONUMENT

STATE PLANE COORDINATES: N _____
E _____


ELEVATION — M.S.L. DATUM: _____

THETA ANGLE: _____

FIELD BOOK: 9411

PAGE _____

CORNER NO. 115
SECTION 32
TOWN 2 N
RANGE 1 W
W 1/4 COR

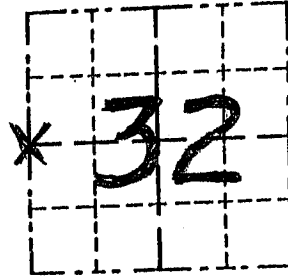


LOCATION
(Indicated by "x")

BASIS FOR MONUMENT LOCATION

(Use reverse side if necessary)

Show info such as: History of corner, with reference to Vol. and pg., dates, surveyor; exact description of monument replaced; if location computed, by taped or EDM traverse; landowner, remarks, etc.

SEAL:

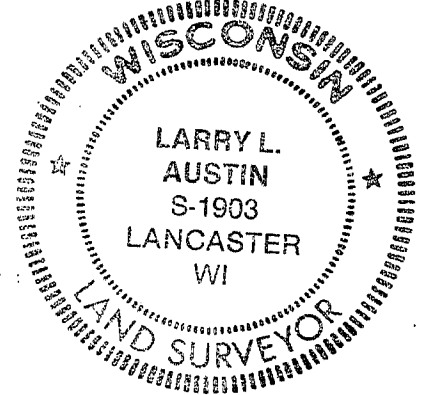

NO RECORD OF CORNER

FOUND SINCE ORIGINAL SURVEYS
IN 1832; I ESTABLISHED E-W
LOCATION BY OCCUPATION &
THE N-S LOCATION AT EQUAL
DISTANCE FROM NE COR & SE
CORNER OF THE SECTION, VERIFIED LOC.
BY EDM TRAVERSE OF THE
AREA.


CERTIFIED CORRECT

Larry L. Austin
Registered Land Surveyor

DATE: 2/4/95

TIE SKETCH

Show at least three (3) ties and monument

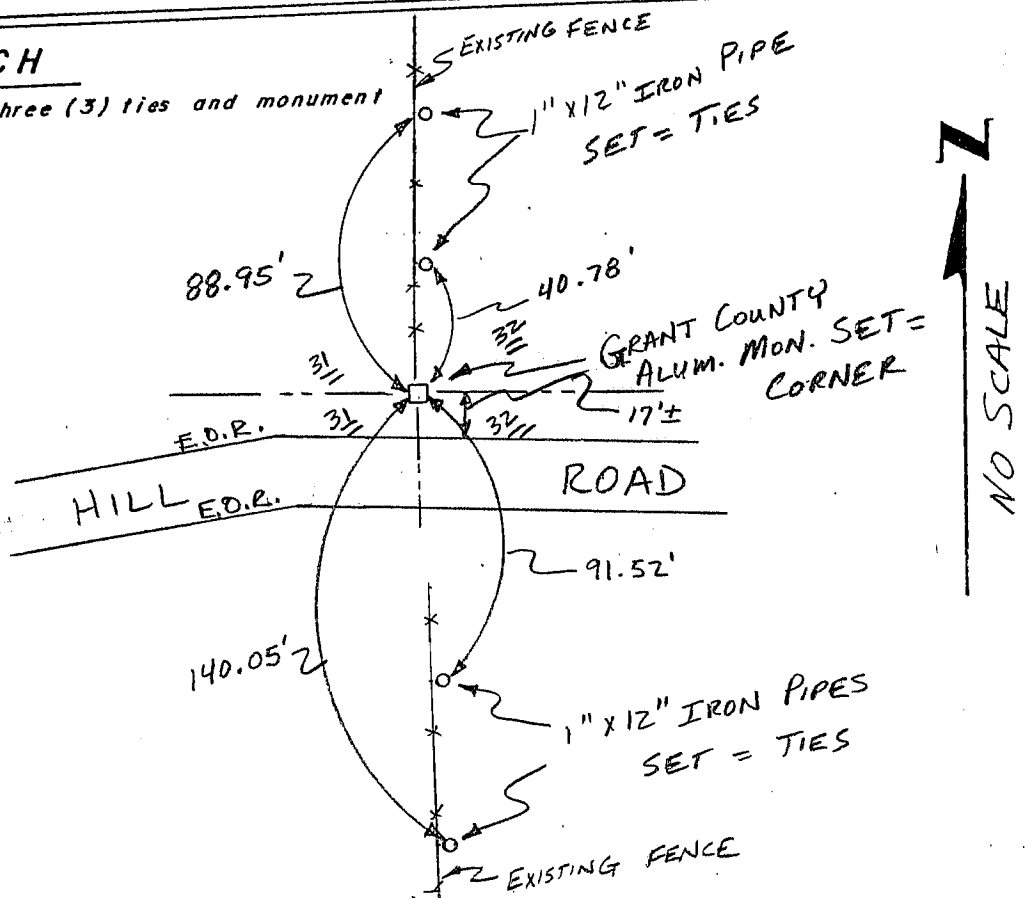

NO SCALE