

CERTIFIED LAND CORNER RESTORATION

State Plane Coordinates

1,853,795.057 x
246,337.734 y

State of Wisconsin }
County of Grant } ss.

I Paul Chafer, do hereby certify that on the 7th day of December, 1984, I found evidence of the East 1/4 corner of Section 1 Township No. 2 North, Range No. 2 West, Fourth Principal Meridian, as described hereon; and that from this evidence I established a new monument and accessories as described hereon to perpetuate the original location of this corner:




Description of original monument and accessories and subsequent restorations:
Government Survey of township was done in 1832-33 by Lucius Lyon.
40.00 Set post 1/4 Section Corner on summit of hill,
W. O. 18" N35W 43

This was the last recorded information of the corner being monumented.
No subsequent surveys could be found which referred to this corner.

Description of corner evidence found:

Corner was established by using existing occupational evidence in a North-South Fence and a "logging line" bearing West, evidenced by large trees North of said line, and small trees to the South, with a large assortment of stumps South also. The overall distance North from this location also compares very well with the original government distance. A thorough surface search was made, and remnants of the original bearing trees sought, but no evidence remains.

Description of monument and accessories I established to perpetuate the location of this corner:

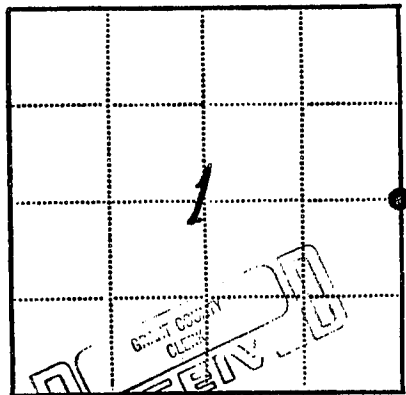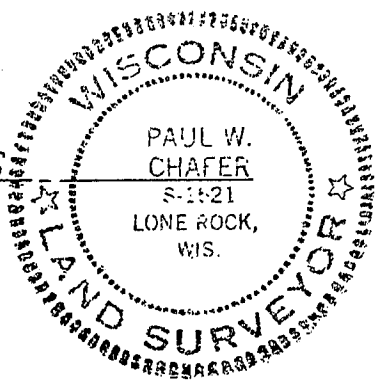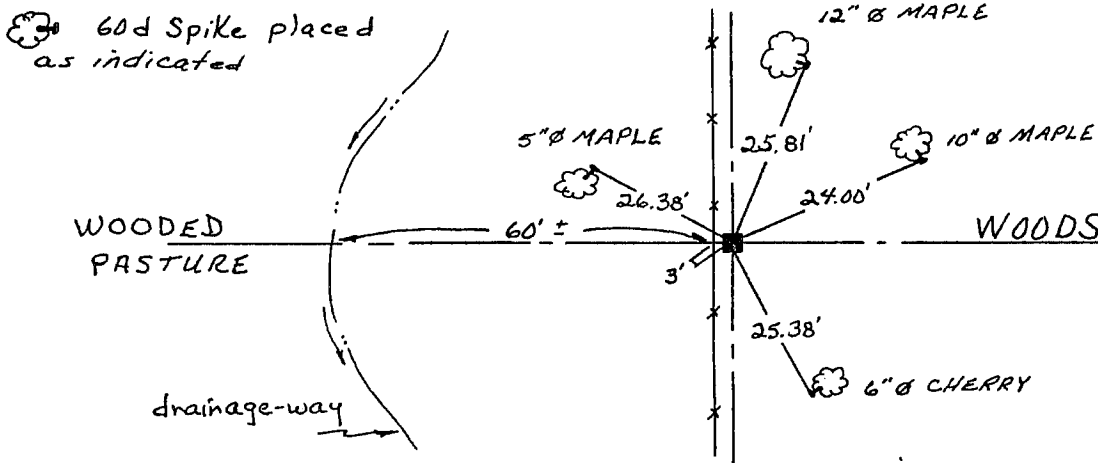

Resident witnesses Terry L. Cornell

Dated at Richland Center, Wisconsin, this 10th day of December 1984.

Signature Paul W. Chafer Title R.L.S.
(County Surveyor, Registered Land Surveyor, or other duly authorized official)

Surveyors Registration No. S-1521

Office of _____ County of _____

I hereby certify that the within instrument was filed in this office for record on the _____ day of _____ 19____, and was filed in Book No. _____ Page No. _____ of County Records.

Signature _____ Title _____

Township 2 North, Range 2 West, Section 1, Index No. _____, Page No. _____

MAY 28 1985

20