

GRANT COUNTY CERTIFIED LAND CORNER

CORNER NUMBER 18

CERTIFICATE:


I, Larry L. Austin, do hereby certify that on the 22nd day of May, 2000, I found evidence of the East 1/4 corner of Section 3, Town 2 North, Range 2 West, of the 4th Principal Meridian, and I re-established said corner according to the Wisconsin statutes as shown and described hereon.

Dated this 17th day of July, 2000

Larry L. Austin
Larry L. Austin S-1903



Grant County Coor.
N 460334.65
E 853340.9

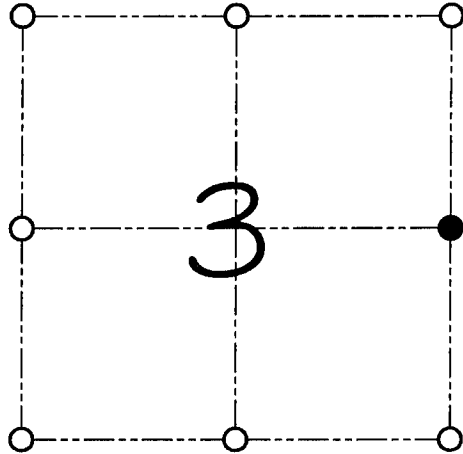

● = CORNER LOCATION
EAST 1/4 CORNER OF SECTION 3, T 2 N R 2 W TOWN OF PARIS

HISTORY OF ORIGINAL CORNER ESTABLISHMENT:

Corner was set in 1833 by Lucius Lyon.
No other record of the corner was found.

DESCRIPTION OF CORNER EVIDENCE FOUND:

I found and accepted an occupied location after an E.D.M. & G.P.S. traverse of the area.

DESCRIPTION OF CORNER AND WITNESS MONUMENTS, references and accessories used to perpetuate the original or re-established location of this corner
WITNESS TO THE CORNER LOCATION: SHANE AUSTIN & JERRY SPEILMAN

SKETCH:

