

GRANT COUNTY

Survey Monument Record

TYPE OF MONUMENT GRANT COUNTY Alum. Mon.

STATE PLANE COORDINATES: N _____
E _____


ELEVATION — M.S.L. DATUM: _____

THETA ANGLE: _____

FIELD BOOK: 94-00

PAGE 27

CORNER NO. 28
SECTION 9
TOWN 2N
RANGE 2W

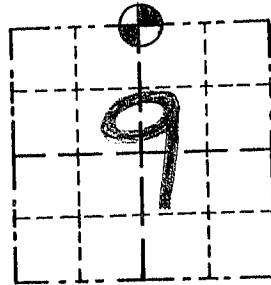

LOCATION
(Indicated by )


BASIS FOR MONUMENT LOCATION

(Use reverse side if necessary)

Show info such as: History of corner, with reference to Vol. and pg., dates, surveyor; exact description of monument replaced; if location computed, by taped or EDM traverse; landowner, remarks, etc.

SEAL:

No RECORD FOUND OF CORNER SINCE ORIGINAL SURVEYS; CORNER WAS SET AT OCCUPIED LOCATION & VERIFIED BY EDM TRAVERSE IN THE AREA.

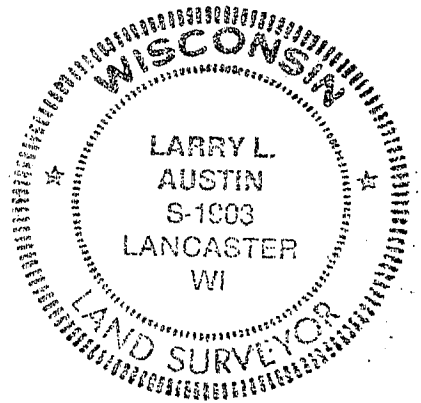


CERTIFIED CORRECT

Larry L. Austin
Registered Land Surveyor

DATE: 4/29/94




TIE SKETCH

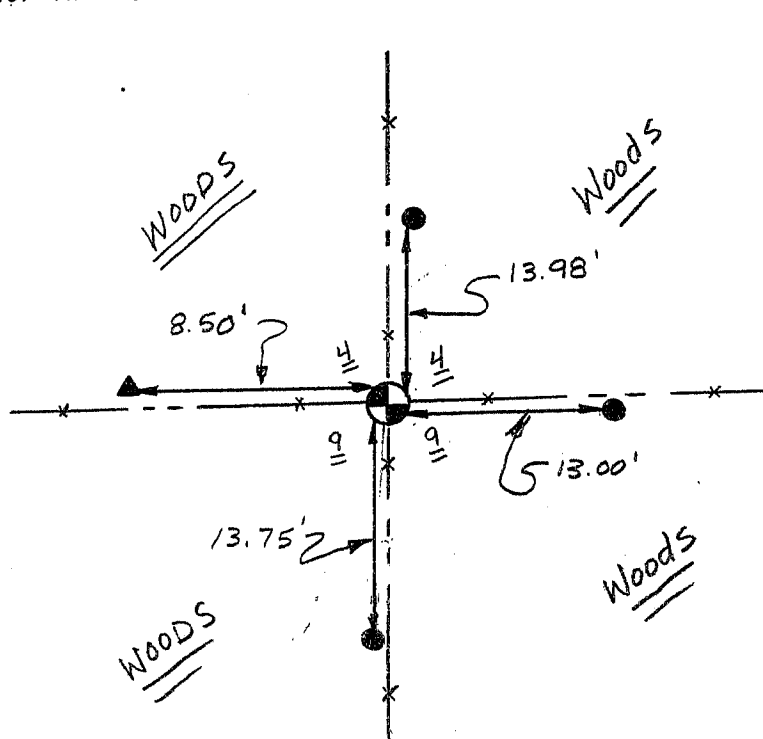Show at least three (3) ties and monument



NO SCALE

LEGEND

-  GRANT COUNTY ALUM MON.
-  1" IRON PIPE
-  3/4" IRON ROD