

GRANT COUNTY CERTIFIED LAND CORNER

CORNER NUMBER 17

CERTIFICATE:

I, Larry L. Austin, do hereby certify that on the 22nd day of May, 2000, I found evidence of the West 1/4 corner of Section 3, Town 2 North, Range 2 West, of the 4th Principal Meridian, and I re-established said corner according to the Wisconsin statutes as shown and described hereon.

Dated this 17th day of July, 2000


Larry L. Austin
Larry L. Austin S-1903



Grant County Corr.

N 460424.2

E 848068.4

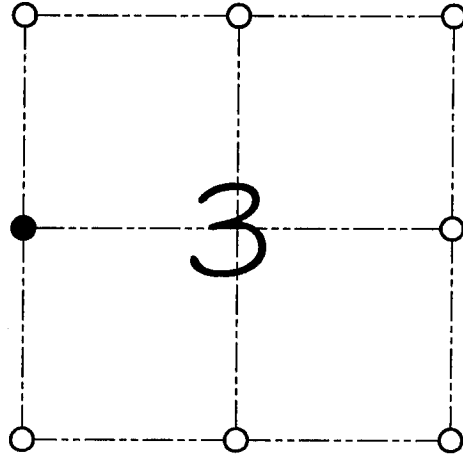

● = CORNER LOCATION

WEST 1/4 CORNER OF
SECTION 3, T 2 N R 2 W
TOWN OF PARIS

HISTORY OF ORIGINAL CORNER ESTABLISHMENT:

Corner was set in 1833 by Lucius Lyon.
In 1988 Douglas Malliet set a #6 iron bar at this location.

DESCRIPTION OF CORNER EVIDENCE FOUND:

I found the #6 iron bar and accepted it's location after an
E.D.M. & G.P.S. traverse of the area.

DESCRIPTION OF CORNER AND WITNESS MONUMENTS, references and accessories used to perpetuate the original or re-established location of this corner

WITNESS TO THE CORNER LOCATION: SHANE AUSTIN & JERRY SPEILMAN

SKETCH:

TIE IS 1'± SOUTHEAST
OF 10 ELM TREE

WOODED PASTURE

LEGEND

- Number 6 iron bar found
- Number 4 by 24" rebar set with red plastic cap
- x- Existing fence location

FIELDS

* SEE SECTION SUMMARY FOR *
RELATIONSHIP TO AREA CORNERS

