


GRANT COUNTY

Survey Monument Record

TYPE OF MONUMENT ALUMINUM MONUMENT
 STATE PLANE COORDINATES: N _____
 E _____
 ELEVATION — M.S.L. DATUM: _____
 THETA ANGLE: _____
 FIELD BOOK: 94-08
 PAGE 9

CORNER NO. 32
 SECTION 7
 TOWN 2N
 RANGE 2W

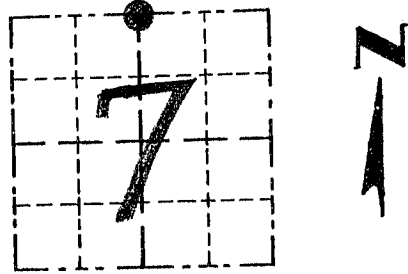

LOCATION
 (Indicated by "●")


BASIS FOR MONUMENT LOCATION

(Use reverse side if necessary)

Show info such as: History of corner, with reference to Vol. and pg., dates, surveyor; exact description of monument replaced; if location computed, by taped or EDM traverse; landowner, remarks, etc.

SEAL:

CORNER WAS SET BASED ON OCCUPATIONAL EVIDENCE. LAST RECORD OF CORNER WAS 1849 SURVEY BY STUNTZ. OCCUPATION LOCATION IS 4.78' LONGER THAN 1849 E-W DIMENSION TO NW CORNER OF THE SECTION.

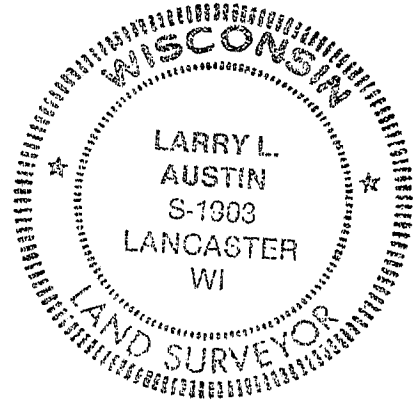

CERTIFIED CORRECT

Larry L. Austin
 Registered Land Surveyor

DATE: 6/6/94

TIE SKETCH

Show at least three (3) ties and monument

