


Survey Monument Record

TYPE OF MONUMENT 3/4" X 24" IRON BAR SET

CORNER NO. 46
 SECTION 10
 TOWN 2N
 RANGE ZW

FIELD BOOK: 96-19
 PAGE 33

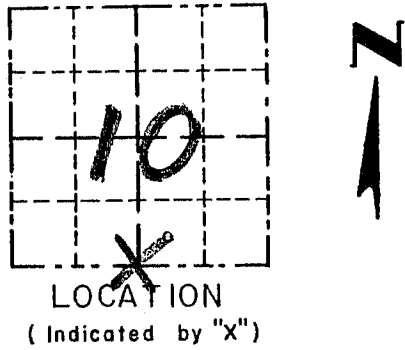


BASIS FOR MONUMENT LOCATION

(Use reverse side if necessary)

Show info such as: History of corner, with reference to Vol. and pg., dates, surveyor; exact description of monument replaced; if location computed, by taped or EDM traverse; landowner, remarks, etc.

SEAL:

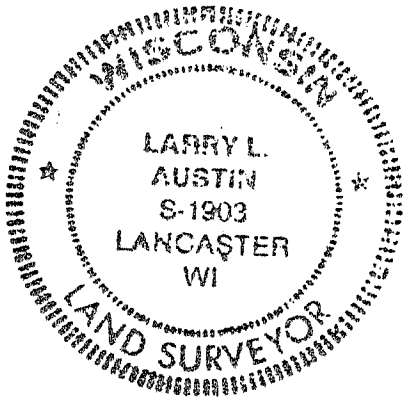

CORNER SET IN 1833 BY LUCIUS LYON. NO RECORD OF CORNER FOUND SINCE ORIGINAL SURVEYS; CORNER WAS SET ONLINE WITH FENCE SOUTH AND WEST. THIS LOCATION FITS WELL WITH CALL TO CREEK OF 5.28' EAST OF CREEK IN ORIGINAL NOTES. VERIFIED ITS LOCATION USING EDM METHODS.

CERTIFIED CORRECT
Larry L. Austin
 Registered Land Surveyor
 DATE: 12/24/96

TIE SKETCH

Show at least three (3) ties and monument

