


GRANT COUNTY CERTIFIED LAND CORNER

CERTIFICATE:

I, LARRY L. AUSTIN, DO HEREBY CERTIFY THAT ON EIGHTH DAY OF MAY, 1999, I FOUND MONUMENTED EVIDENCE OF THE EAST 1/4 CORNER SECTION 12, TOWN 2 NORTH, RANGE 2 WEST, OF THE FOURTH PRINCIPAL MERIDIAN, AND I RE-ESTABLISHED SAID CORNER ACCORDING TO THE WISCONSIN STATUTES AS SHOWN AND DESCRIBED HEREON.


DATED THIS TWENTY-SECOND DAY OF MAY, 1999

Larry L. Austin
LARRY L. AUSTIN S-1903

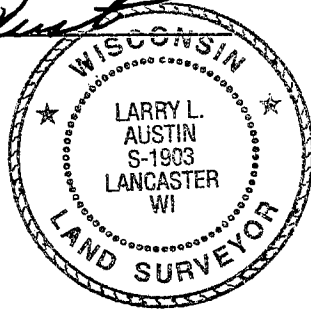

SEAL

CORNER NUMBER 40

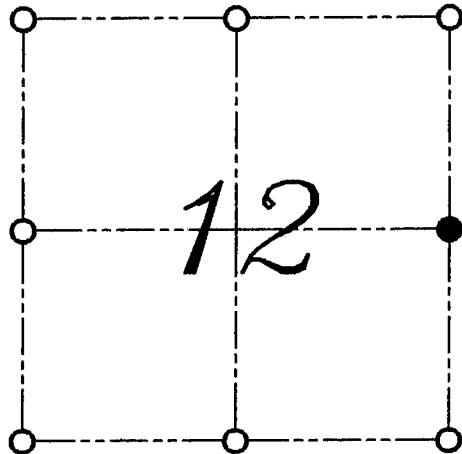

● = CORNER LOCATION

EAST 1/4 CORNER OF
SECTION 12, T 2 N R 2 W
TOWN OF PARIS

HISTORY OF ORIGINAL CORNER ESTABLISHMENT:


CORNER WAS SET IN 1833 BY LUCIUS LYON.
I SET THE CORNER IN 1998.

DESCRIPTION OF CORNER EVIDENCE FOUND:

I FOUND AND ACCEPTED THE 3/4" IRON BAR AFTER AN E.D.M. AND G.P.S. TRAVERSE OF THE AREA.

DESCRIPTION OF CORNER AND WITNESS MONUMENTS, REFERENCES AND ACCESSORIES USED TO PERPETUATE THE ORIGINAL OR RE-ESTABLISHED LOCATION OF THIS CORNER:
WITNESS TO THE CORNER LOCATION: BOBBY SEDGWICK ; SHELBY BLINDERT

SKETCH:

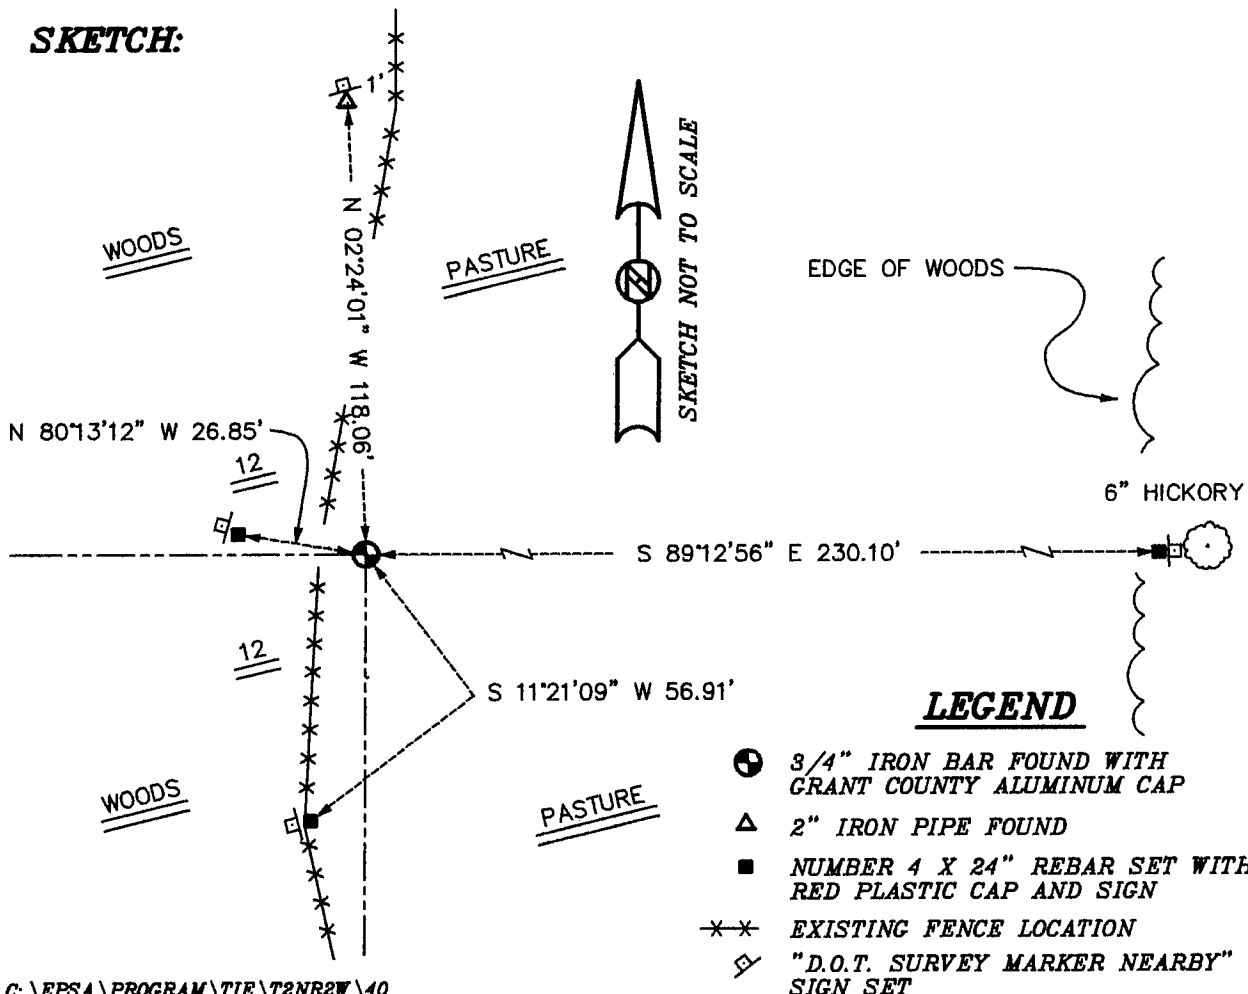

LEGEND


- 3/4" IRON BAR FOUND WITH GRANT COUNTY ALUMINUM CAP
- ▲ 2" IRON PIPE FOUND
- NUMBER 4 X 24" REBAR SET WITH RED PLASTIC CAP AND SIGN
- *** EXISTING FENCE LOCATION
- ⊠ "D.O.T. SURVEY MARKER NEARBY" SIGN SET

Survey Monument Record

TYPE OF MONUMENT 3/4" X 24" IRON
BAR SET

CORNER NO. 34
SECTION 07
TOWN 2N
RANGE LW

FIELD BOOK: 97-26
PAGE 7

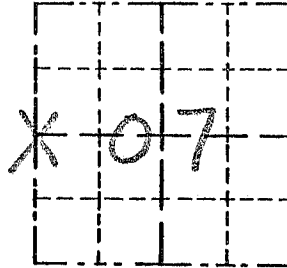


BASIS FOR MONUMENT LOCATION

(Use reverse side if necessary)

Show info such as: History of corner, with reference to Vol. and pg., dates, surveyor; exact description of monument replaced; if location computed, by taped or EDM traverse; landowner, remarks, etc.

SEAL:

CORNER SET IN 1832 BY LULIUS LYON. IN 1856 OVERTON SURVEYED A 29.93 ACRE PARCEL, NO MONUMENT PLACED. CORNER WAS SET MIDWAY ONLINE BETWEEN NORTHWEST AND SOUTHWEST CORNERS OF SECTION, VERIFIED ITS LOCATION USING EDM METHODS.

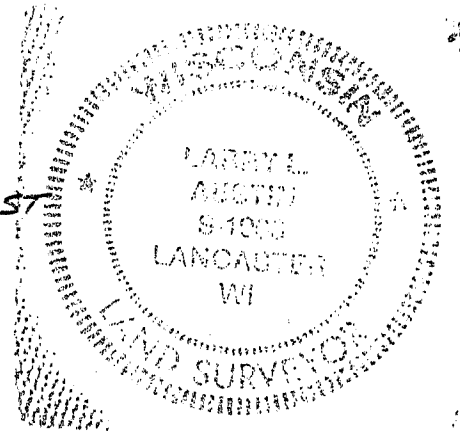

CERTIFIED CORRECT

Larry L. Austin
Registered Land Surveyor

DATE: 1-16-98

TIE SKETCH

Show at least three (3) ties and monument

LEGEND

- ⊙ 3/4" X 24" IRON BAR SET
- 1/2" X 15" IRON BAR SET
- XX EXISTING FENCE
- △ 2" IRON PIPE

