

U.S. PUBLIC LAND SURVEY MONUMENT RECORD

Section 18, Town 2 North Range 1 West, Town of Smelser, Grant County, Wisconsin

CERTIFICATE

I, Larry L. Austin, do hereby certify that the corner location on this record was determined by me and/or under my direct supervision and that this U.S. public land survey monument record is correct and complete to the best of my knowledge and belief.

Larry L. Austin
Larry L. Austin, S-1903



HISTORY OF CORNER


Corner was originally set in 1832 by Lyon.
No other record of the corner was found.

CORNER EVIDENCE FOUND

I found an existing fence corner and accepted it after an EDM & GPS traverse of the area.

DESCRIPTION OF CORNER AND WITNESS MONUMENTS, references and accessories used to perpetuate the original or re-established location of this corner. Witnesses to monument location Bobby Sedgwick & Brad Digman & Shane Austin

SKETCH:

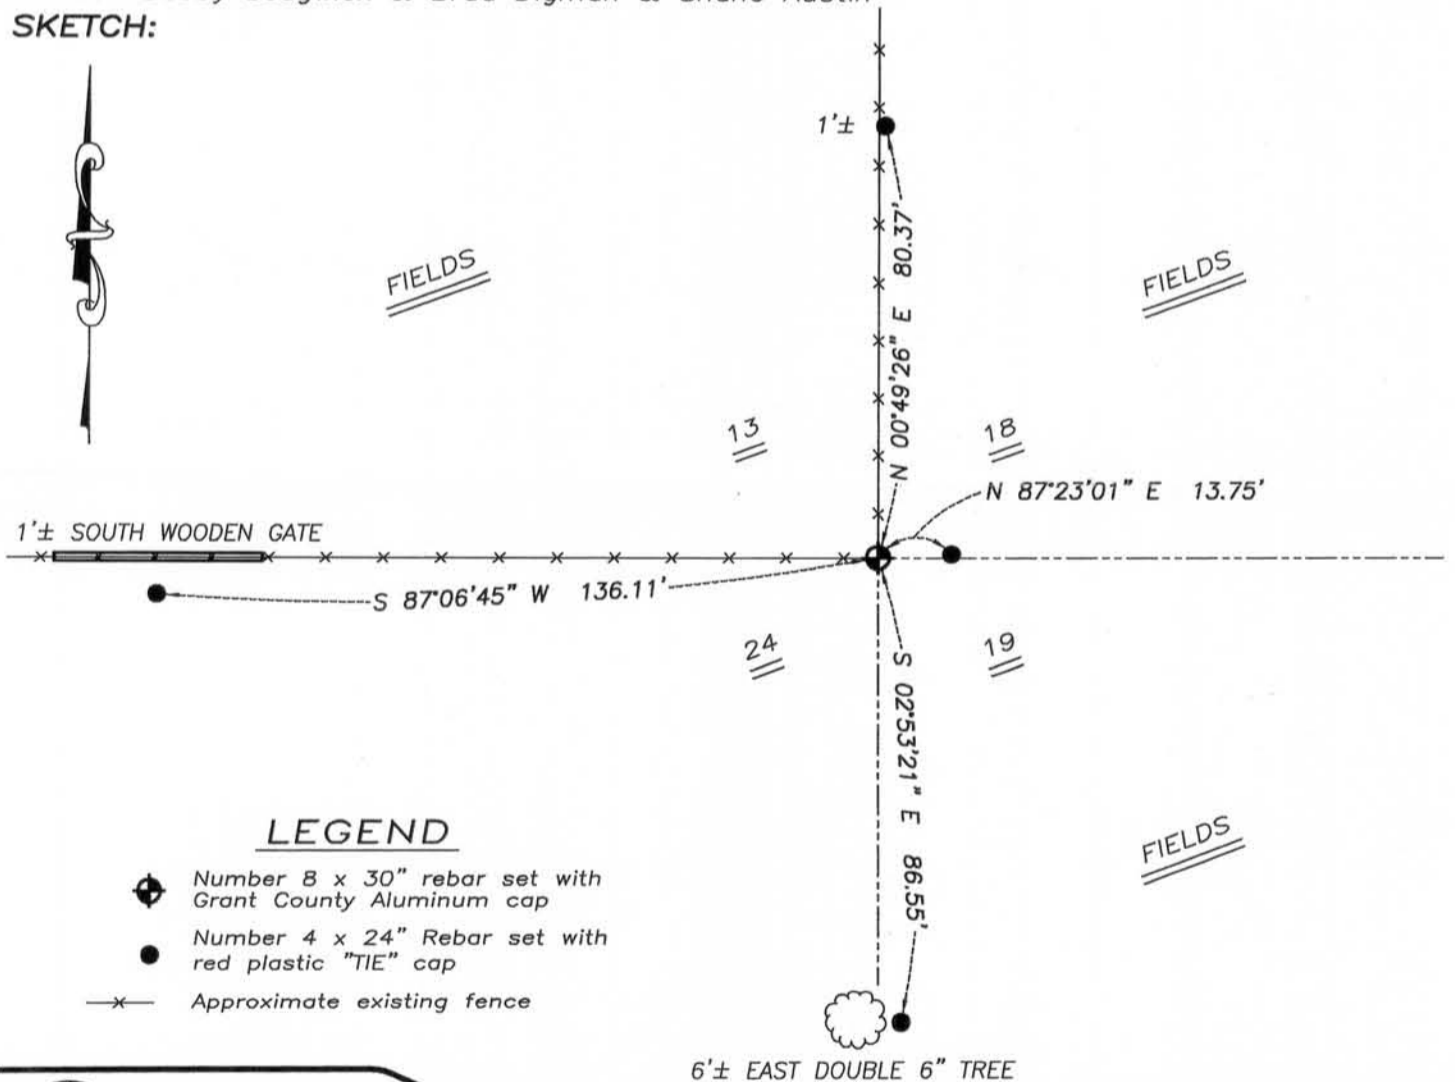

LEGEND

- Number 8 x 30" rebar set with Grant County Aluminum cap
- Number 4 x 24" Rebar set with red plastic "TIE" cap
- x— Approximate existing fence

NOT TO SCALE



Austin
Engineering LLC

4211 HWY 81 E, LANCASTER, WI 53813
PHONE 608-723-6363 FAX 608-723-6702

JOB NUMBER 05S271
FIELDBOOK: TDSR, 2812
G:\T2NR1W\17
H:\TIE\T2NR1W\73

DRAWN BY: SW AUSTIN
APPROVED: LL AUSTIN

73

FEB 23 2011