

LAND LIE TO 8-1 (21)


9-1-61

COUNTY GRANT

TOWN OF PARIS

T. 2. N. - R. 7. E

INTERSECTION OF  
NORTH - SOUTH LINE FENCE  
AND EAST - WEST LINE FENCE

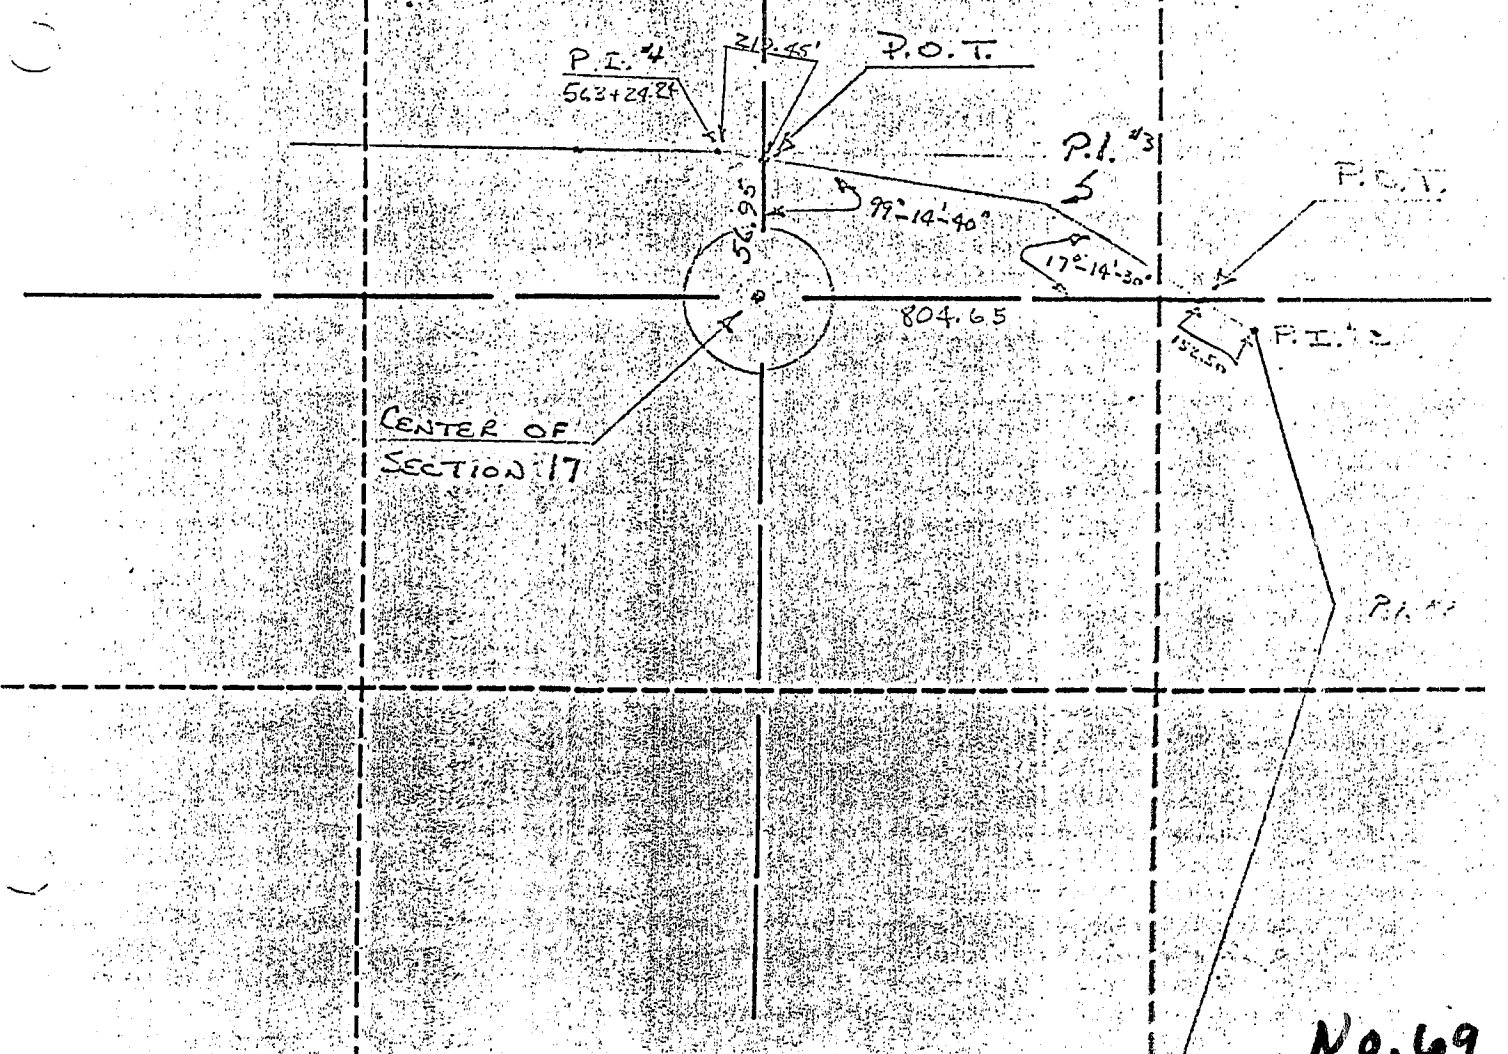

No. 69