


Survey Monument Record

TYPE OF MONUMENT 3/4" X 24" IRON
BAR SET

CORNER NO. 82
SECTION 25
TOWN ZN
RANGE ZW

FIELD BOOK: 97-01
PAGE _____

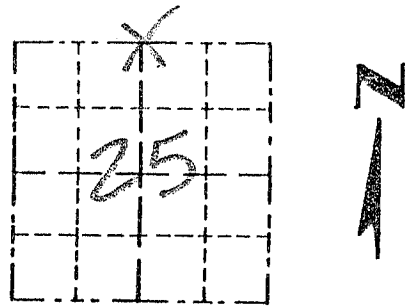

LOCATION
(Indicated by "X")


BASIS FOR MONUMENT LOCATION

(Use reverse side if necessary)

Show info such as: History of corner, with reference to Vol. and pg., dates, surveyor; exact description of monument replaced; if location computed, by taped or EDM traverse; landowner, remarks, etc.

SEAL:

CORNER SET IN 1833 BY LUCIUS LYON, NO RECORD OF CORNER FOUND SINCE ORIGINAL SURVEY; CORNER WAS SET MIDWAY, ONLINE BETWEEN THE NORTH WEST AND THE NORTHEAST CORNERS, VERIFIED THIS LOCATION USING EDM METHODS.

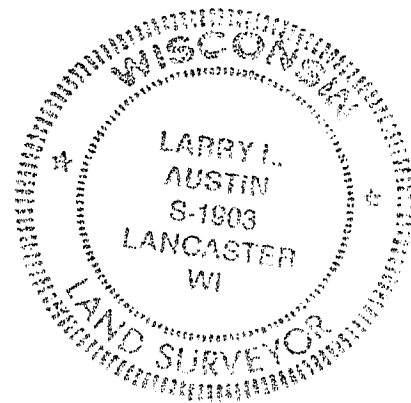

CERTIFIED CORRECT

Larry L. Austin
Registered Land Surveyor

DATE: 11-16-97

TIE SKETCH

Show at least three (3) ties and monument

LEGEND

- 3/4" X 24" IRON BAR SET
18" BELOW GRADE
- 1/2" X 15" IRON BAR SET
15" BELOW GRADE

