


Survey Monument Record

TYPE OF MONUMENT 3/4" X 24" IRON  
BAR SET

CORNER NO. 99  
 SECTION 25  
 TOWN 2N  
 RANGE 2W

FIELD BOOK: 97-01  
 PAGE \_\_\_\_\_

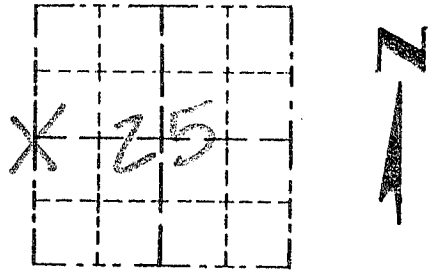

LOCATION  
 (Indicated by "X")


BASIS FOR MONUMENT LOCATION

(Use reverse side if necessary)

Show info such as: History of corner, with reference to Vol. and pg., dates, surveyor; exact description of monument replaced; if location computed, by taped or EDM traverse; landowner, remarks, etc.

CORNER SET IN 1833 BY LUCIUS LYON. IN 1975 HOMER RALPH TIED TO THE CORNER. I FOUND AN EXISTING OCCUPIED FENCE CORNER. ACCEPTED IT AFTER EDM TRAVERSE OF AREA.

SEAL:

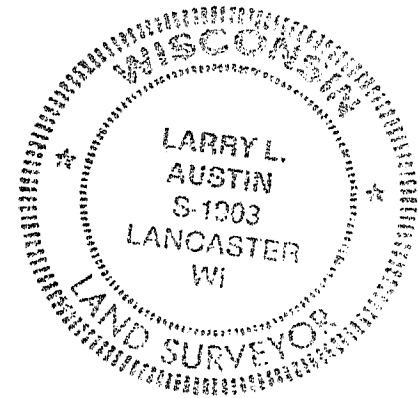

CERTIFIED CORRECT

*Larry L. Austin*  
 Registered Land Surveyor

DATE: 11-16-98

TIE SKETCH

Show at least three (3) ties and monument

LEGEND

- 3/4" X 24" IRON BAR SET
- 1/2" X 15" IRON BAR SET
- \*\* EXISTING FENCE

