


GRANT COUNTY

REC'D MAR 8 1996

Survey Monument Record

CORNER NO. 107
 SECTION 33
 TOWN 2N
 RANGE 2W

TYPE OF MONUMENT COUNTY ALUMINUM MON.
 STATE PLANE COORDINATES: N _____
 E _____
 ELEVATION — M.S.L. DATUM: _____
 THETA ANGLE: _____
 FIELD BOOK: 9407
 PAGE 30

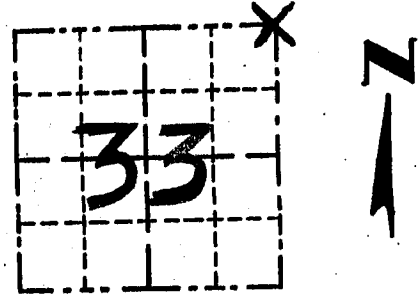

LOCATION
(Indicated by "X")

BASIS FOR MONUMENT LOCATION

(Use reverse side if necessary)

Show info such as: History of corner, with reference to Vol. and pg., dates, surveyor; exact description of monument replaced; if location computed, by taped or EDM traverse; landowner, remarks, etc.

SEAL:

CORNER ORIGINALLY SET IN 1833
 BY LUCIUS LYON; NO RECORD OF CORNER
 FOUND SINCE ORIGINAL SURVEY;
 I SET THE CORNER AT OCCUPIED
 LOCATION AFTER VERIFICATION BY
 EDM TRAVERSE OF THE AREA



CERTIFIED CORRECT

Larry L. Austin
 Registered Land Surveyor
 DATE: 4/10/95

TIE SKETCH

Show at least three (3) ties and monument

LEGEND

- ⊕ ALUMINUM MONUMENT = CORNER
- 1" x 12" IRON PIPES = TIES
- *** EXISTING FENCE

