

GRANT COUNTY

REC'D MAR 8 1996

Survey Monument Record

TYPE OF MONUMENT COUNTY ALUMINUM MON.

STATE PLANE COORDINATES: N _____
E _____

ELEVATION — M.S.L. DATUM: _____

THETA ANGLE: _____

FIELD BOOK: 94-07


PAGE 30

CORNER NO. 108

SECTION 33

TOWN 2 N

RANGE 2 W

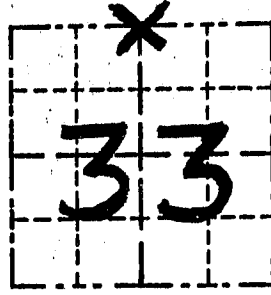

LOCATION
(Indicated by "X")

BASIS FOR MONUMENT LOCATION

(Use reverse side if necessary)

Show info such as: History of corner, with reference to Vol. and pg., dates, surveyor; exact description of monument replaced; if location computed, by taped or EDM traverse; landowner, remarks, etc.

SEAL:

CORNER WAS SET 1833 BY LUCIUS LYON
NO RECORD OF CORNER FOUND SINCE
ORIGINAL SURVEYS; I ACCEPTED E-W
FENCE FOR N-S LOCATION & SET EW
LOCATION AT CENTER OF BRACE POSTS
GOING BOTH E & W. THIS LOCATION
VERIFIED BY EDM TRAVERSE OF THE
AREA.



CERTIFIED CORRECT

Larry L. Austin
Registered Land Surveyor

DATE: 4/10/95

TIE SKETCH

Show at least three (3) ties and monument

LEGEND

- ⊕ GRANT COUNTY ALUMINUM MONUMENT SET
- 1" x 12" IRON PIPE SET-TIES

