

# GRANT COUNTY

## Survey Monument Record

CORNER NO. 111  
 SECTION 30  
 TOWN 2N  
 RANGE 2W

TYPE OF MONUMENT 3/4" X 24" IRON BAR SET


STATE PLANE COORDINATES: N \_\_\_\_\_  
 E \_\_\_\_\_

ELEVATION — M.S.L. DATUM: \_\_\_\_\_

THETA ANGLE: \_\_\_\_\_

FIELD BOOK: 96-12

PAGE (16)

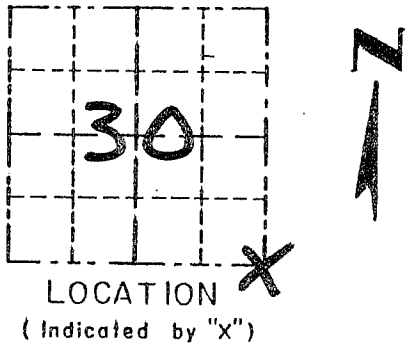

### BASIS FOR MONUMENT LOCATION

(Use reverse side if necessary)

CORNER SET IN 1833 BY

LUCIUS LYON. ORIGINAL BEARING.

TREES WERE UNRECOVERABLE. SEAL:

NO RECORD OF CORNER FOUND

SINCE ORIGINAL SURVEYS. CORNER

SET IN EXISTING FENCE FOR EAST/

WEST. LOCATION. NORTH/SOUTH

LOCATION ESTABLISHED BY

BEING ONLINE WITH A EXISTING


FENCE FROM THE EAST. THIS

LOCATION FIT VERY WELL 1/2 MILE

SOUTH TO 1" IRON PIPE. VERIFIED

ITS LOCATION USING EDM

TRAVERSE.

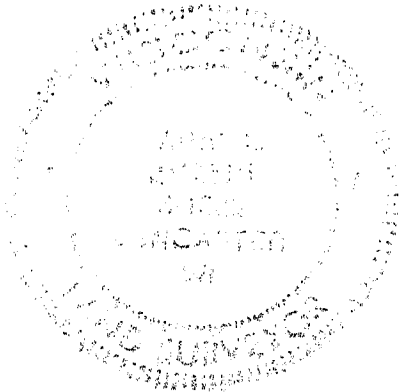

CERTIFIED CORRECT

*Harry R. Hunt*  
 Registered Land Surveyor

DATE: 8/29/96

### TIE SKETCH

Show at least three (3) ties and monuments

#### LEGEND

⊕ 3/4" X 24" IRON BAR SET

○ 1/2" X 18" IRON BAR SET

XX EXISTING FENCE

