


GRANT COUNTY

Survey Monument Record

TYPE OF MONUMENT 3/4" x 24" IRON BAR
 STATE PLANE COORDINATES: N _____
 E _____
 ELEVATION — M.S.L. DATUM: _____
 THETA ANGLE: _____
 FIELD BOOK: 95-01
 PAGE 23

CORNER NO. 18
 SECTION 2
 TOWN 2N
 RANGE 3W
W 1/4 COR.

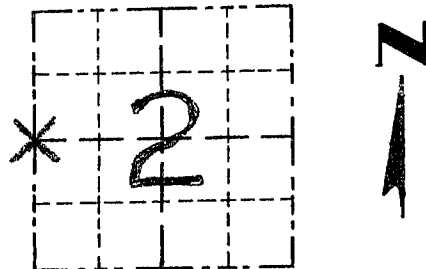

LOCATION
 (Indicated by "X")


BASIS FOR MONUMENT LOCATION

(Use reverse side if necessary)

Show info such as: History of corner, with reference to Vol. and pg., dates, surveyor; exact description of monument replaced; if location computed, by taped or EDM traverse; landowner, remarks, etc.

ORIGINAL CORNER SET IN 1833
 BY LUCIUS LYON. NO RECORD FOUND
 SINCE ORIGINAL SURVEY. CORNER WAS
 RESTABLISHED MIDWAY BETWEEN THE
 NW COR AND SW CORNER.

SEAL:

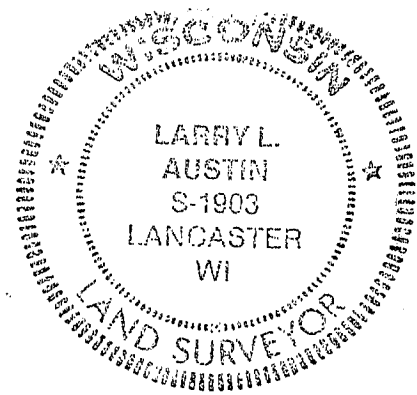

CERTIFIED CORRECT

Larry L. Austin
 Registered Land Surveyor

DATE: 2/27/95

TIE SKETCH

Show at least three (3) ties and monument

- LEGEND
- 3/4" x 24" IRON BAR SET
 - 1" IRON PIPE SET = TIES

