

# U. S. PUBLIC LAND SURVEY MONUMENT RECORD


**INSTRUCTIONS :**

This record shall show the location of the corner and shall include all of the following nine elements (a through i).


(a) Identify the corner by reference to the U.S. public land survey system.

○ = Corner monument restored.

WEST 1/4 CORNER of SECTION  
14, TOWN 3 NORTH, RANGE  
1 WEST, CITY of PLATTEVILLE,  
GRANT COUNTY, WISCONSIN.

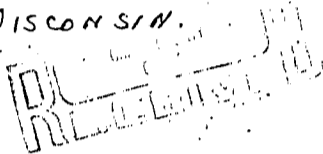

AUG 6 1986

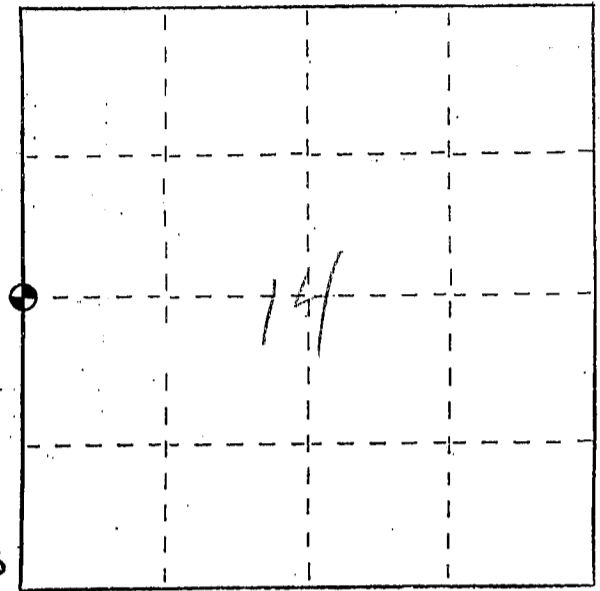

(b) Describe any record evidence, monument evidence, occupational evidence, testimonial evidence or any other material evidence you considered, and whether the monument was found or placed.

PIPE SET OVER EXISTING 1/2" SOLID ROD AS FOUND BY DAVID A. DAVIS AND RECORDED ON "MAP OF PROPOSED MAIN STREET EXTENSION and SURROUNDING AREAS", AS PREPARED IN 1978.

(c) In the plan view drawing below, provide reference ties to at least 4 witness monuments, or, if the location is within a municipality, to at least 2 witness monuments. (Witness monuments shall be made of concrete, natural stone, iron or other equally durable material.) Describe witness monuments.

(d) Show a plan view drawing depicting the relevant monuments and reference ties which is sufficient in detail to enable accurate relocation of the corner monument if the corner monument is disturbed. Indicate north.

