

# U.S. PUBLIC LAND SURVEY MONUMENT RECORD

(AS REQUIRED BY s.A-E 7.08, WI. ADM. CODE)

HISTORY OF ORIGINAL CORNER ESTABLISHMENT AND SUBSEQUENT RESTORATIONS AND DESCRIPTION OF ANY RECORD, MONUMENT, OCCUPATION, TESTIMONIAL OR OTHER EVIDENCE CONSIDERED

THE CORNER WAS PREVIOUSLY SET AND TIE SHEET DATED SEP 22 1987 IN GRANT CO.

COORDINATES ARE ESTABLISHED TO THE CORNER AND WITNESS TIES AS SHOWN BELOW BEARING REFERENCE AND COORDINATES ARE LAFAYETTE COUNTY COORDINATE SYSTEM NAD 83(91) ENGLISH SYSTEM

LAFAYETTE COUNTY COORDINATES  
 NORTHING 172345.82  
 EASTING 400184.17


CORNER WAS: ( CHECK ALL THAT APPLY)

- RESTORED THROUGH ACCEPTANCE OF AN OBLITERATED EVIDENCE LOCATION
- RESTORED THROUGH ACCEPTANCE OF A FOUND PERPETUATED LOCATION  
 CONSIDERED A LOST CORNER AND REESTABLISHED THROUGH LOST CORNER PROPORTIONATE METHODS  
 (INCLUDE A PLAN VIEW DRAWING SHOWING BEARING & DISTANCE TO OTHER PUBLIC LAND SURVEY CORNERS  
 (INCLUDE FOR PLAN VIEWING AND DETERMINING THE CORNER LOCATION)
- RESTORED OR REESTABLISHED IN A LOCATION THAT DIFFERS FROM A PREVIOUS RESTORATION OR REESTABLISHMENT  
 (INCLUDE A PLAN VIEW DRAWING AND INDICATE WHAT WAS SET AND/OR FOUND)

Describe the monument and accessories used to perpetuate the location of the corner. (Include a plan view drawing and indicated what was set and/or found)

**LEGEND:**

- △ SET 5/8"φ REBAR TIE
- FOUND STONE MONUMENT
- ⊠ FOUND REBAR WITH LAF. CO. ALUM CAP
- ⊡ FOUND BERNSTEIN ALUM. MONUMENT - GRANT CO, CAP
- ( ) RECORDED AS
- ⊗ FD. RING SHANK NAIL
- x—x— FENCE
- ▲ FOUND 3/8"φ IRON ROD

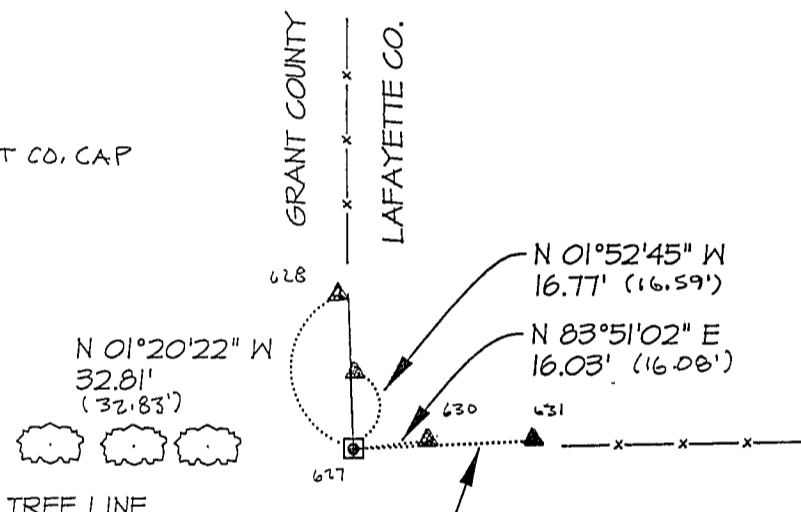


SECT 25	SECT 30
TOWN 3 N	TOWN 3 N
RANGE 1W	RANGE 1E
SECT 36	SECT 31
TOWN 3 N	TOWN 3 N
RANGE 1W	RANGE 1E

● = LOCATION OF CORNER  
 THE SE COR. OF SECT 25 T. 3 N, R. 1W  
 THE NE COR. OF SECT 36 T. 3 N, R. 1W  
 THE SW COR. OF SECT 30 T. 3 N, R. 1E  
 THE NW COR. OF SECT 31 T. 3 N, R. 1E

LAFAYETTE & GRANT COUNTY, WISCONSIN  
 JOB ID: 075-006 BOOK #: 2007-2 P.15

I, LAURENCE E SCHMIT CERTIFY THAT THE CORNER LOCATION SHOWN ON THIS RECORD WAS DETERMINED BY ME OR UNDER MY DIRECTION AND CONTROL AND THAT THIS U.S. PUBLIC LAND SURVEY MONUMENT RECORD IS CORRECT AND COMPLETE TO THE BEST OF MY KNOWLEDGE AND BELIEF.

Laurence E Schmit 5-8-07

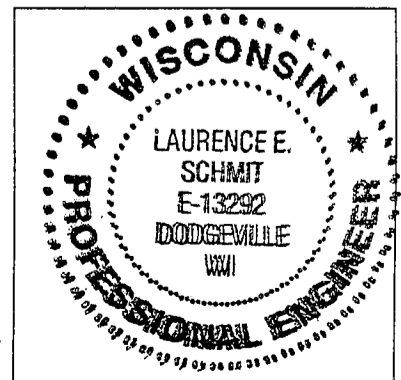

LAND SURVEYORS SEAL

SIGNATURE

DATE:


INDEX NUMBER 113

# U. S. PUBLIC LAND SURVEY MONUMENT RECORD

INSTRUCTIONS: This record shall show the location of the corner and shall include all of the following nine elements (a through i).

- (a) Identify the corner by reference to the U.S. public land survey system.
- = Corner monument restored.

Southeast  $\frac{1}{4}$  of Section 25,  
Town 3 North, Range 1 West,  
Platteville Township, Grant  
County, Wisconsin.

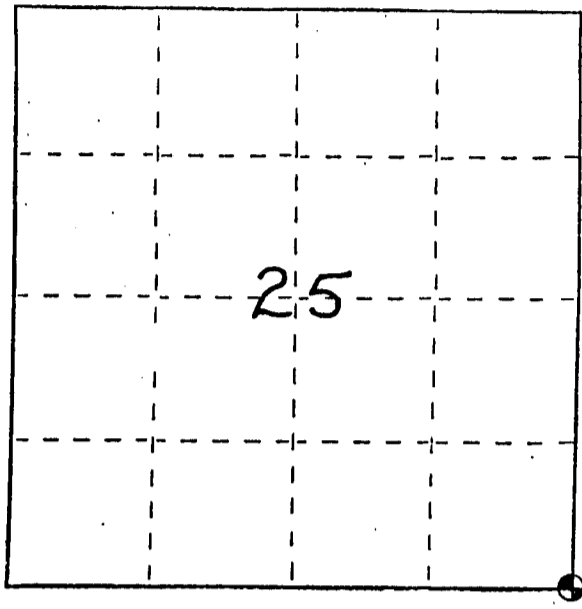

- (b) Describe any record evidence, monument evidence, occupational evidence, testimonial evidence or any other material evidence you considered, and whether the monument was found or placed.


Monument set from existing physical evidence after verification by proportionate measurements from an EDM traverse of the area. There is no record evidence of this corner since the original post and mound in prairie as shown on the original government survey.

- (c) In the plan view drawing below, provide reference ties to at least 4 witness monuments, or, if the location is within a municipality, to at least 2 witness monuments. (Witness monuments shall be made of concrete, natural stone, iron or other equally durable material.) Describe witness monuments.

- (d) Show a plan view drawing depicting the relevant monuments and reference ties which is sufficient in detail to enable accurate relocation of the corner monument if the corner monument is disturbed. Indicate north.

LEGEND

- Bernsten drivable aluminum monument
- 3/8" x 24" round, solid iron rod
- Set post
- Wire panel gate
- \*\*\* Fence

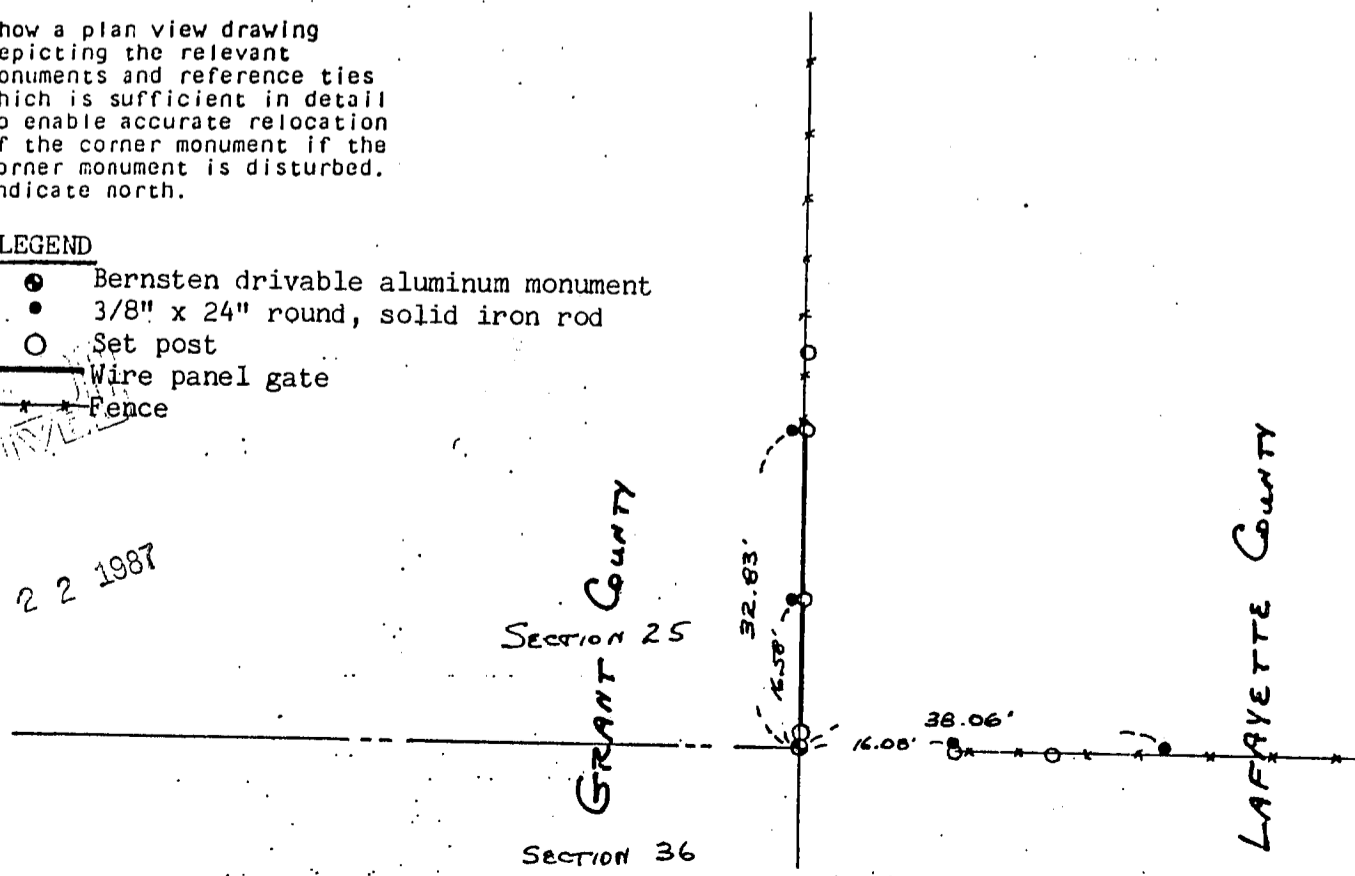

SEP 22 1987

(e) Describe any material discrepancy between the location of the corner as restored or reestablished and the location of that corner as previously restored or reestablished by distance and direction. Show the discrepancy on the plan view drawing under (d), above. Show the distances between the corner as previously restored or reestablished and (1) the corner as restored or reestablished, and (2) to at least 2 of the witness monuments shown on the drawing in (d), above.

NONE


(f) Was the corner restored through acceptance of (1) an obliterated evidence location, or, (2) a found perpetuated location?

(1) an obliterated evidence location

(g&h) Was the corner reestablished through lost corner proportionate methods? If so, show the method, including the directions and distances to other public land survey corners used as evidence or used for proportioning in determining the corner location?

No

SE 25

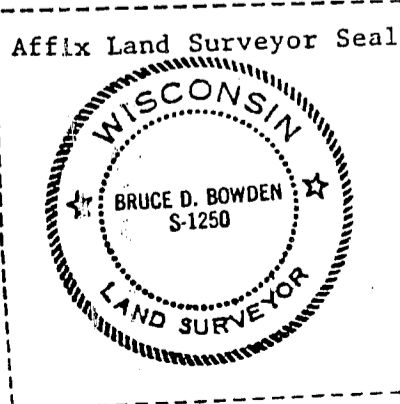

(i) I, Bruce D. Bowden, R.L.S. - 1250 (type or print name) certify that the corner location shown on this record was determined by me or under my direction and control and that this U.S. Public Land Survey Monument Record is correct and complete to the best of my knowledge and belief.

Bruce D. Bowden  
Signature

Sept 7, 1987  
Date