


Survey Monument Record

TYPE OF MONUMENT 3/4" X 24" IRON BAR SET

CORNER NO. 115  
 SECTION 31  
 TOWN 3N  
 RANGE 1W

FIELD BOOK: 97-33  
 PAGE \_\_\_\_\_

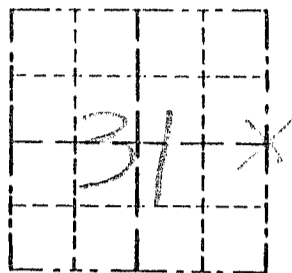

LOCATION  
 (Indicated by "X")


BASIS FOR MONUMENT LOCATION

(Use reverse side if necessary)

Show info such as: History of corner, with reference to Vol. and pg, dates, surveyor; exact description of monument replaced; if location computed, by taped or EDM traverse; landowner, remarks, etc.

SEAL:

CORNER SET IN 1833 BY ROBERT CLARK. NO RECORD OF CORNER FOUND SINCE ORIGINAL SURVEY; CORNER WAS SET AT A OCCUPIED LOCATION. VERIFIED ITS LOCATION USING EDM METHODS.

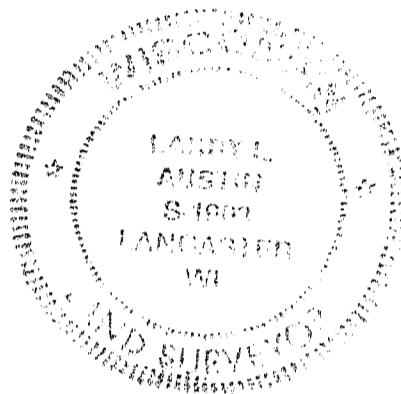

CERTIFIED CORRECT

*Larry L. Angin*  
 Registered Land Surveyor

DATE: 12/5/97

TIE SKETCH

Show at least three (3) ties and monument

LEGEND

- 3/4" X 24" IRON BAR SET
- 1/2" X 15" IRON BAR SET

--- EXISTING FENCE

