

GRANT COUNTY

Survey Monument Record

TYPE OF MONUMENT 3/4" X 24" IRON Rod SET

STATE PLANE COORDINATES: N W/ CAP
E _____


ELEVATION — M.S.L. DATUM: _____

THETA ANGLE: _____

FIELD BOOK: FB # 96-04

PAGE _____

CORNER NO. 7
SECTION 3
TOWN 2N
RANGE 1W

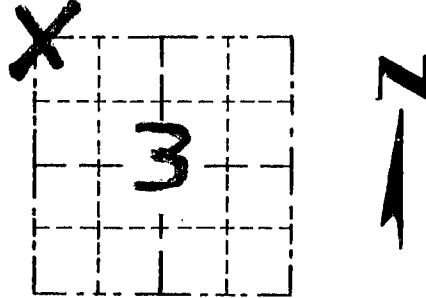


LOCATION
(Indicated by "X")

BASIS FOR MONUMENT LOCATION

(Use reverse side if necessary)

NO RECORD FOUND SINCE ORIGINAL SURVEY IN 1832 BY L40N. I ACCEPTED OCCUPATION LOCATION & VERIFIED BY EDM TRAVERSE OF THE AREA

SEAL:

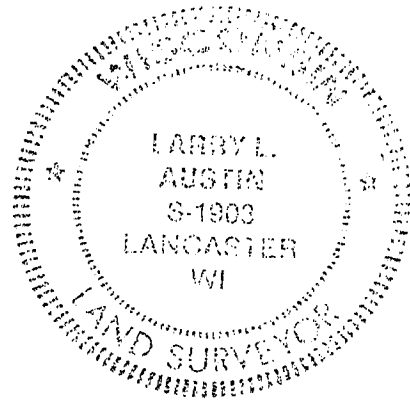

CERTIFIED CORRECT

Larry L. Austin
Registered Land Surveyor

DATE: 5-7-96


TIE SKETCH

Show at least three (3) ties and monument

- LEGEND**
- 3/4" X 24" IRON ROD SET W/ CAP
 - 1/2" X 15" IRON ROD SET AS TIES
 - X --- EXISTING FENCE
 - TREE

PASTURE

YARD

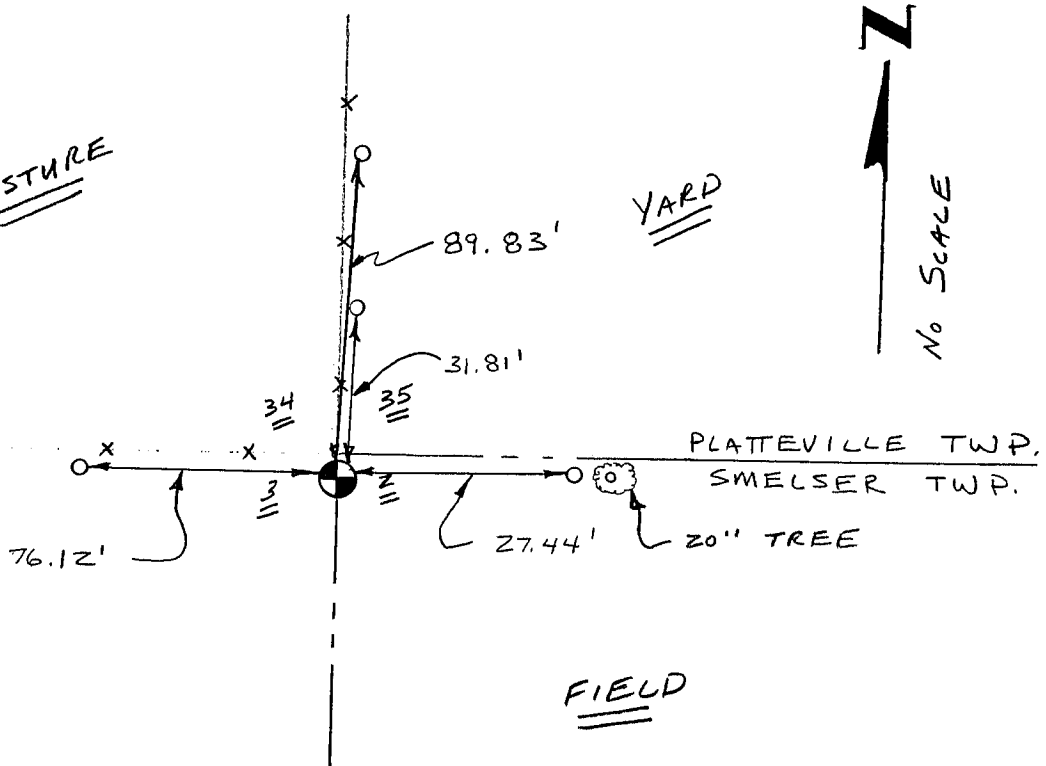

FIELD

FIELD