


Survey Monument Record

TYPE OF MONUMENT 3/4" X 24" IRON BAR
SET

CORNER NO. 30
 SECTION 05
 TOWN 3N
 RANGE 2W

FIELD BOOK: 97-13
 PAGE (13)

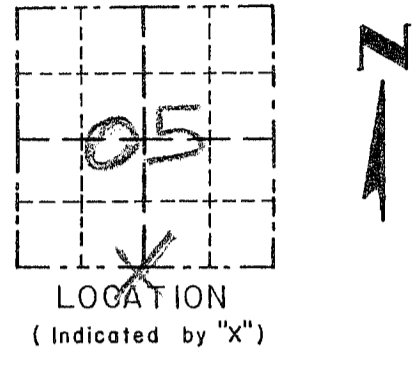


BASIS FOR MONUMENT LOCATION

(Use reverse side if necessary)
 Show info such as: History of corner, with reference to Vol. and pg., dates, surveyor; exact description of monument replaced; if location computed, by taped or EDM traverse; landowner, remarks, etc.

SEAL:

CORNER WAS SET IN 1833 BY ROBERT CIARK. IN 1855 OVERTON FOUND ORIGINAL CORNER. IN 1881 J. SCOTT FOUND ORIGINAL CORNER AND TIED TO NEW BEARING TREE. I FOUND A OCCUPIED FENCE CORNER. ACCEPTED ITS LOCATON AFTER EDM TRAVERSE OF AREA.

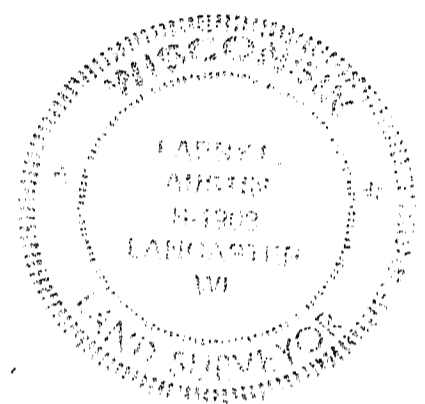

CERTIFIED CORRECT
Kathy S. Gust
 Registered Land Surveyor
 DATE: 9-12-97

TIE SKETCH

Show at least three (3) ties and monument

LEGEND

- ⊕ 3/4" X 24" IRON BAR SET
- 1/2" X 15" IRON BAR SET
- EXISTING FIELDS FENCE

