


GRANT COUNTY

Survey Monument Record


TYPE OF MONUMENT ALUMINUM MONUMENT
STATE PLANE COORDINATES: N _____
E _____
ELEVATION — M.S.L. DATUM: _____
THETA ANGLE: _____
FIELD BOOK: 92-01
PAGE 38

CORNER NO. 31
SECTION 7
TOWN 3 N
RANGE 2 W

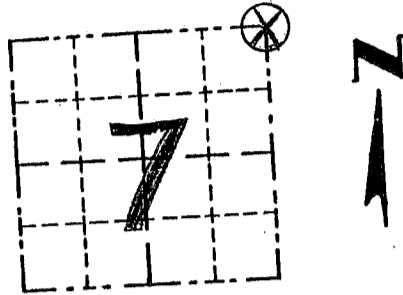

LOCATION
(Indicated by "X")

SEAL:

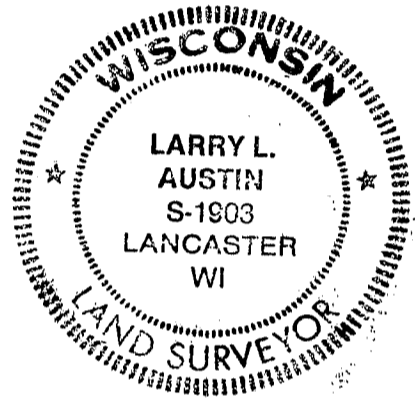

BASIS FOR MONUMENT LOCATION

(Use reverse side if necessary)

Show info such as: History of corner, with reference to Vol. and pg., dates, surveyor; exact description of monument replaced; if location computed, by taped or EDM traverse; landowner, remarks, etc.

MONUMENT WAS PLACED
BASED ON OCCUPATIONAL
EVIDENCE & VERIFIED BY
EDM TRAVERSE.

CERTIFIED CORRECT

Larry L. Austin
Registered Land Surveyor


DATE: 10/15/93

TIE SKETCH

Show at least three (3) ties and monument

LEGEND

- ALUM. MON. SET
- 3/8" x 12" STEEL PEGS = TIES
- X — EXISTING FENCE

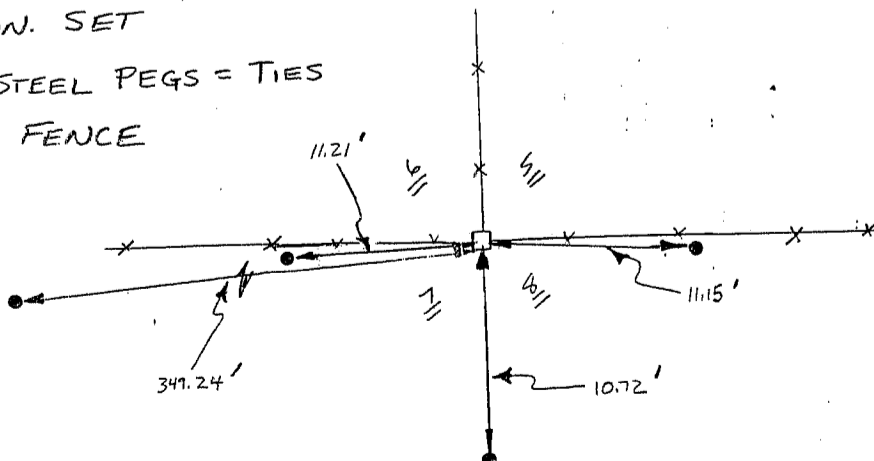

NO SCALE