


Survey Monument Record

TYPE OF MONUMENT 3/4" X 24" IRON
BAR SET

CORNER NO. 15
SECTION 05
TOWN 3N
RANGE 2W

FIELD BOOK: 97-13
PAGE 13

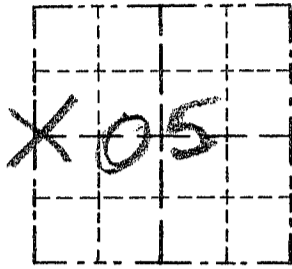

LOCATION
(Indicated by "X")


BASIS FOR MONUMENT LOCATION

(Use reverse side if necessary)

Show info such as: History of corner, with reference to Vol. and pg., dates, surveyor; exact description of monument replaced; if location computed, by taped or EDM traverse; landowner, remarks, etc.

SEAL:

CORNER SET IN 1833 BY ROBERT CLARK. IN 1855 OVERTON FOUND ORIGINAL CORNER. I SET THE CORNER AT A EXISTING FENCE CORNER. VERIFIED ITS LOCATION USING EDM METHODS.

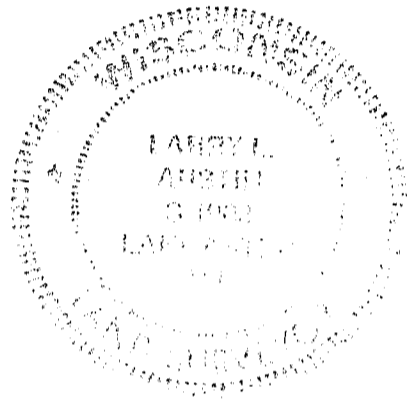

CERTIFIED CORRECT

Larry L. Austin
Registered Land Surveyor

DATE: 9-12-97

TIE SKETCH

Show at least three (3) ties and monument

LEGEND

- 3/4" X 24" IRON BAR SET
- 1/2" X 15" IRON BAR SET
- EXISTING FENCE
- PASTURE

