

GRANT COUNTY

Survey Monument Record

TYPE OF MONUMENT ALUMINUM MONUMENT

STATE PLANE COORDINATES: N _____
E _____


ELEVATION — M.S.L. DATUM: _____

THETA ANGLE: _____

FIELD BOOK: 92-01

PAGE _____

CORNER NO. 35
SECTION 7
TOWN 3 N
RANGE 2 W

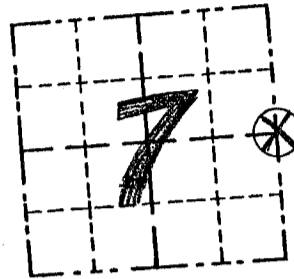

LOCATION
(Indicated by 'X')


BASIS FOR MONUMENT LOCATION

(Use reverse side if necessary)

Show info such as: History of corner, with reference to Vol. and pg., dates, surveyor; exact description of monument replaced; if location computed, by taped or EDM traverse; landowner, remarks, etc.

MONUMENT WAS PLACED
BASED ON OCCUPATIONAL
EVIDENCE (EAST-WEST) & VERIFIED BY
PROPORTIONAL MEAS.
NO RECORD OF CORNER FD.
SINCE ORIG. SURVEYS
LOCATION CHECKS WELL
WITH A CALL IN ORIG.
NOTES TO CREEK BED.

SEAL:

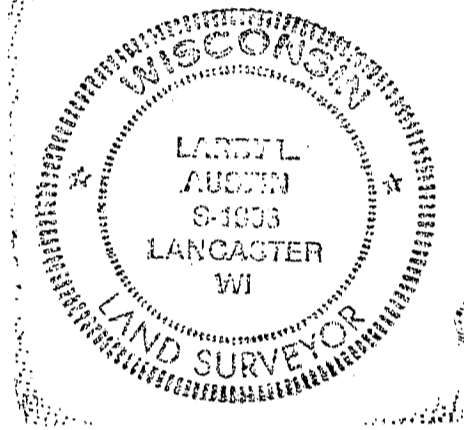


CERTIFIED CORRECT

Larry A. Austin
Registered Land Surveyor

DATE: 10-15-93

TIE SKETCH

Show at least three (3) ties and monument

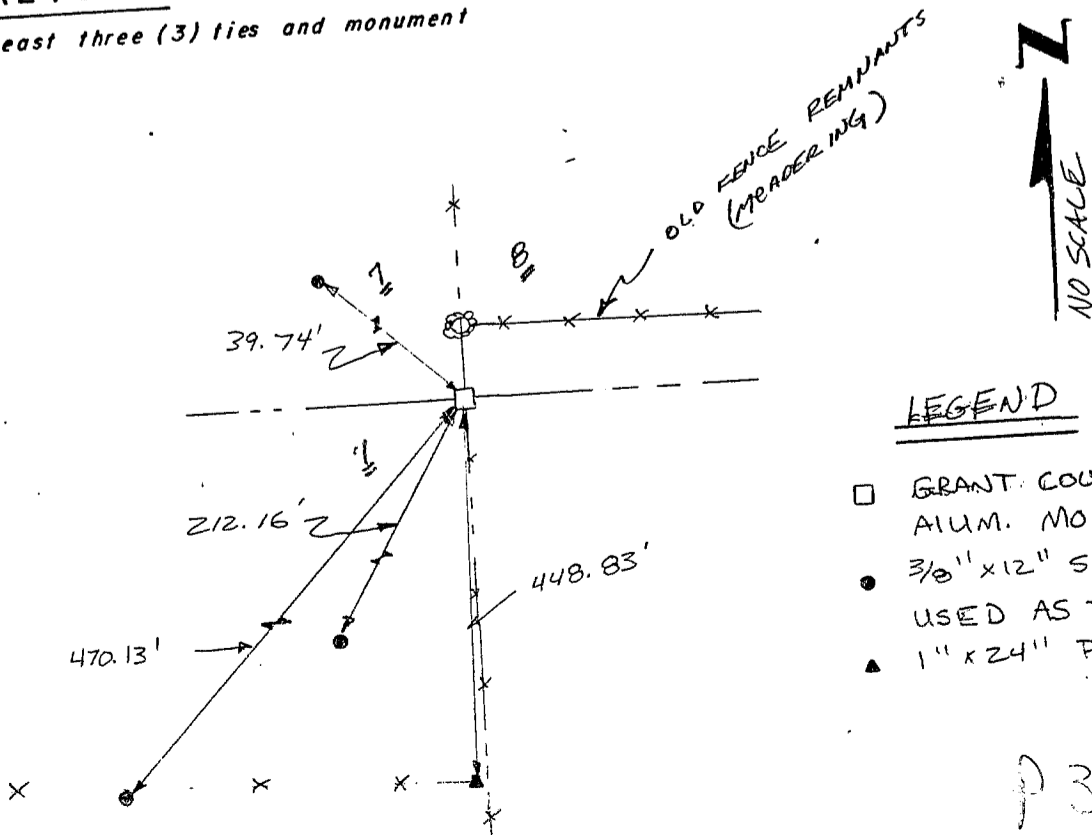

LEGEND

- GRANT COUNTY ALUM. MON
- 3/8" x 12" SPIKES USED AS TIES
- ▲ 1" x 24" PIPE

P 35