

CORNER DESCRIPTION: SE CORNER, SECTION 15, T 3 N, R 2 W

*Harrison
1-8*

STATE PLANE COORDINATES: N _____, E _____

THETA ANGLE: _____

HORIZONTAL DATUM: WISCONSIN STATE PLANE COORDINATE SYSTEM, SOUTH ZONE



EVIDENCE: HARRISON CEMETARY LIES WEST OF CORNER, USED SOUTH LINE OF CEMETARY AND SW CORNER OF CEMETARY AND RECORD DISTANCE TO SECTION CORNER - CEMETARY ORIGINALLY SURVEYED - PAROLE

MONUMENT: FOUND , PLACED

METHOD OF RESTORATION (RE-ESTABLISHMENT):

- ACCEPTED EXISTING MONUMENT
 - N , E ACCEPTED OCCUPATION
 - N , E LOST CORNER PROPORTIONATE METHODS
- DATE CORNER SET: 12/16/85

- LEGEND**
- ▲ SET #6 REBAR, 113 LBS PER LINEAL FT. MIN WT
 - SET 1" X 24" IRON PIPE, 113 LBS PER LINEAL FT. MIN WT
 - SET 2" X 30" IRON PIPE, 365 LBS PER LINEAL FT. MIN WT
 - FOUND 1" IRON PIPE
 - FOUND 2" IRON PIPE
 - FOUND R/R SPIKE
 - SET R/R SPIKE
 - ⊙ GOVERNMENT CORNER
 - EXISTING FENCE

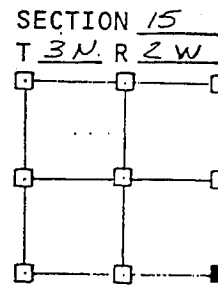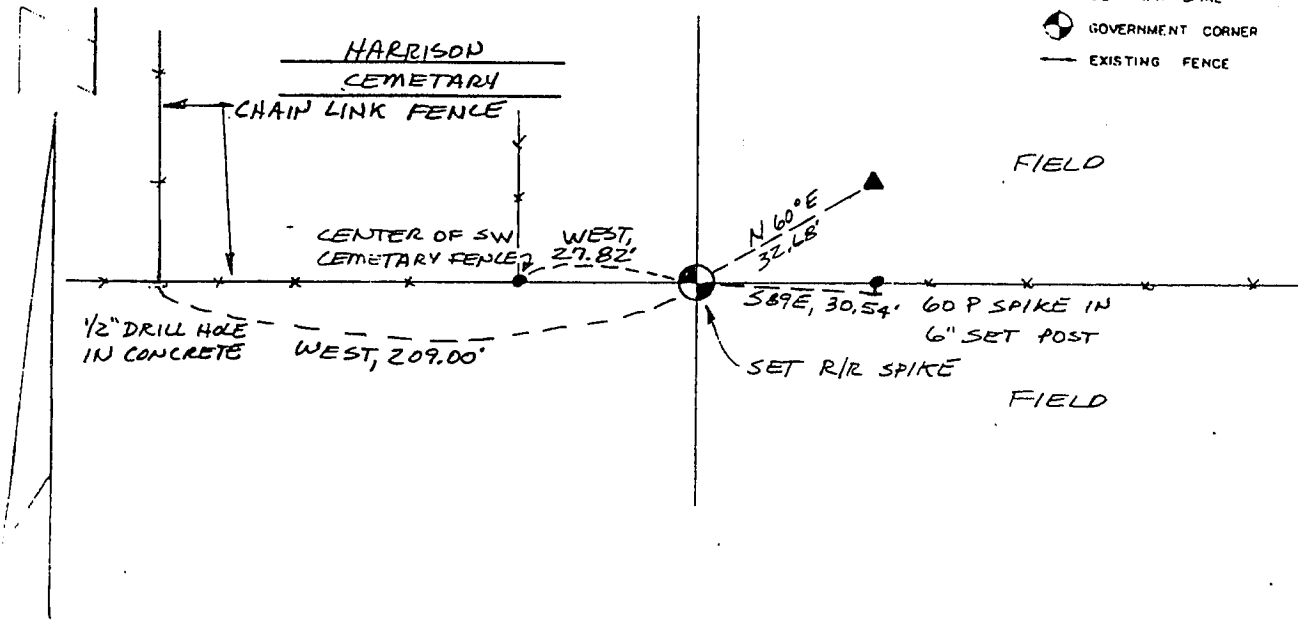

NOT TO SCALE THIS CONFORMS TO WISCONSIN ADMINISTRATIVE CODE A-F 5.02

SURVEYOR'S AFFIDAVIT:
STATE OF WISCONSIN)
GRANT COUNTY) SS

I hereby certify that I, _____, have complied with the Wisconsin State Statutes, Statutes of the United States, and the rules and regulations made by the Secretary of the Interior in the location of the corner shown above.

DATE OF SURVEY: 12/17/85
Douglas J. Malliet
REGISTERED LAND SURVEYOR
1266



D. F. BURBACH MUNICIPAL & CIVIL ENGINEERS
410 NORTH SECOND STREET • PLATTEVILLE, WISCONSIN 53818 • (608) 348-3262

p-65