


Survey Monument Record

TYPE OF MONUMENT 3/4" x 24" IRON BAR W/ ALUM. CAP SET

CORNER NO. _____
 SECTION 22
 TOWN 3 N
 RANGE 2 W
 NW CORNER

FIELD BOOK: 9507
 PAGE _____

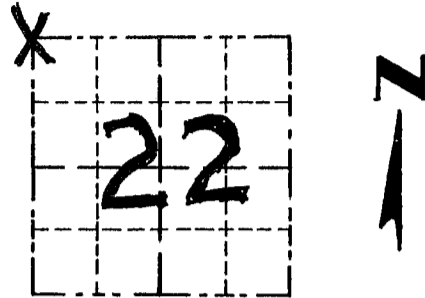

LOCATION
 (Indicated by "X")


BASIS FOR MONUMENT LOCATION

(Use reverse side if necessary)

Show info such as: History of corner, with reference to Vol. and pg., dates, surveyor; exact description of monument replaced; if location computed, by taped or EDM traverse; landowner, remarks, etc.

SEAL:

ORIGINAL CORNER SET IN 1833 BY ROBERT CLARK; NO RECORD OF THE CORNER FOUND, SINCE, I SET THE CORNER AT AN OCCUPATION LOCATION AFTER VERIFICATION BY EDM TRAVERSE OF THE AREA.

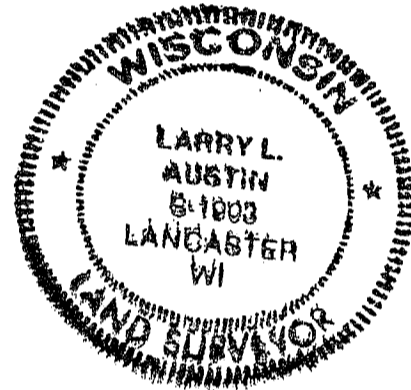


CERTIFIED CORRECT

Larry L. Austin
 Registered Land Surveyor

DATE: 6/25/96

TIE SKETCH

Show at least three (3) ties and monument

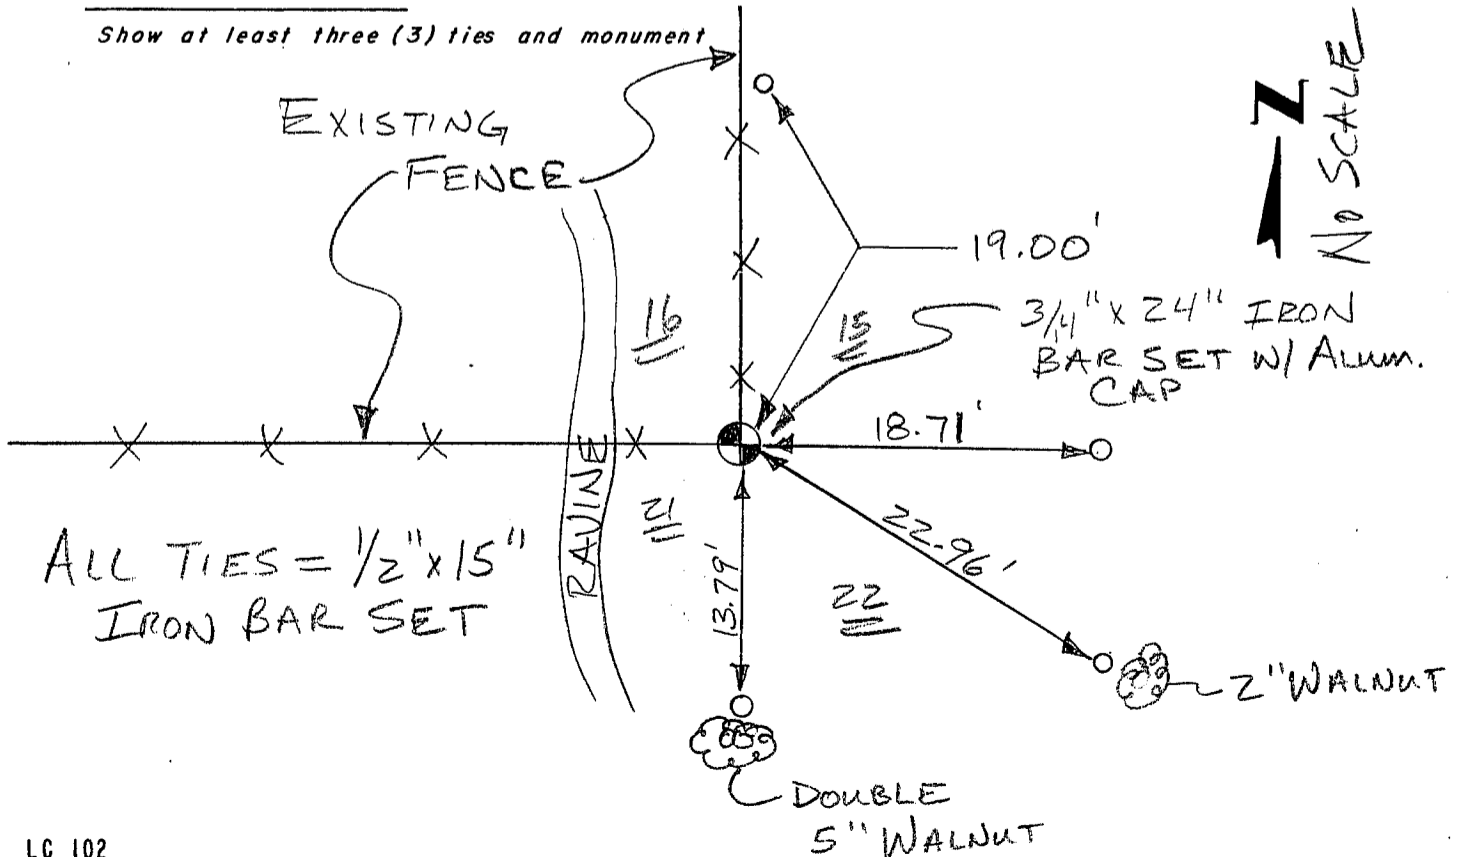

ALL TIES = 1/2" x 15" IRON BAR SET