

GRANT COUNTY CERTIFIED LAND CORNER

CORNER NUMBER 68

CERTIFICATE:


I, Larry L. Austin, do hereby certify that on the 6th day of January, 2001, I found evidence of the South 1/4 corner of Section 16, Town 3 North, Range 2 West, of the 4th Principal Meridian, and I re-established said corner according to the Wisconsin statutes as shown and described hereon.

Dated this 12th day of February, 2001

Larry L. Austin
Larry L. Austin S-1903



SEAL

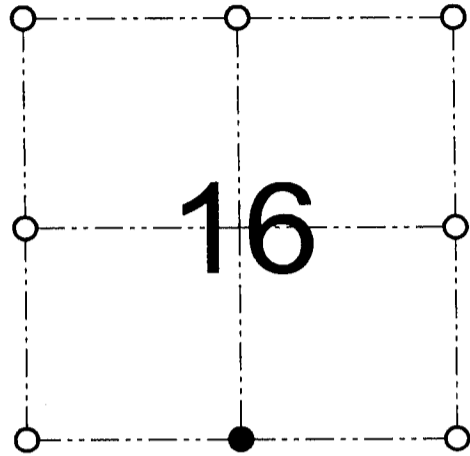

● = CORNER LOCATION

SOUTH 1/4 CORNER OF
SECTION 16, T 3 N R 2 W
TOWN OF HARRISON

HISTORY OF ORIGINAL CORNER ESTABLISHMENT:

Corner was originally set in 1832 by Robert Clark.
No other record of the corner was found.


DESCRIPTION OF CORNER EVIDENCE FOUND:

I found an occupied fence corner and accepted it's location
after an EDM & GPS traverse of the area.

DESCRIPTION OF CORNER AND WITNESS MONUMENTS, references and accessories used to perpetuate the original or re-established location of this corner

WITNESS TO THE CORNER LOCATION: TIM FAUVER & SHELBY BLINDERT & BOBBY SEDGWICK

SKETCH:

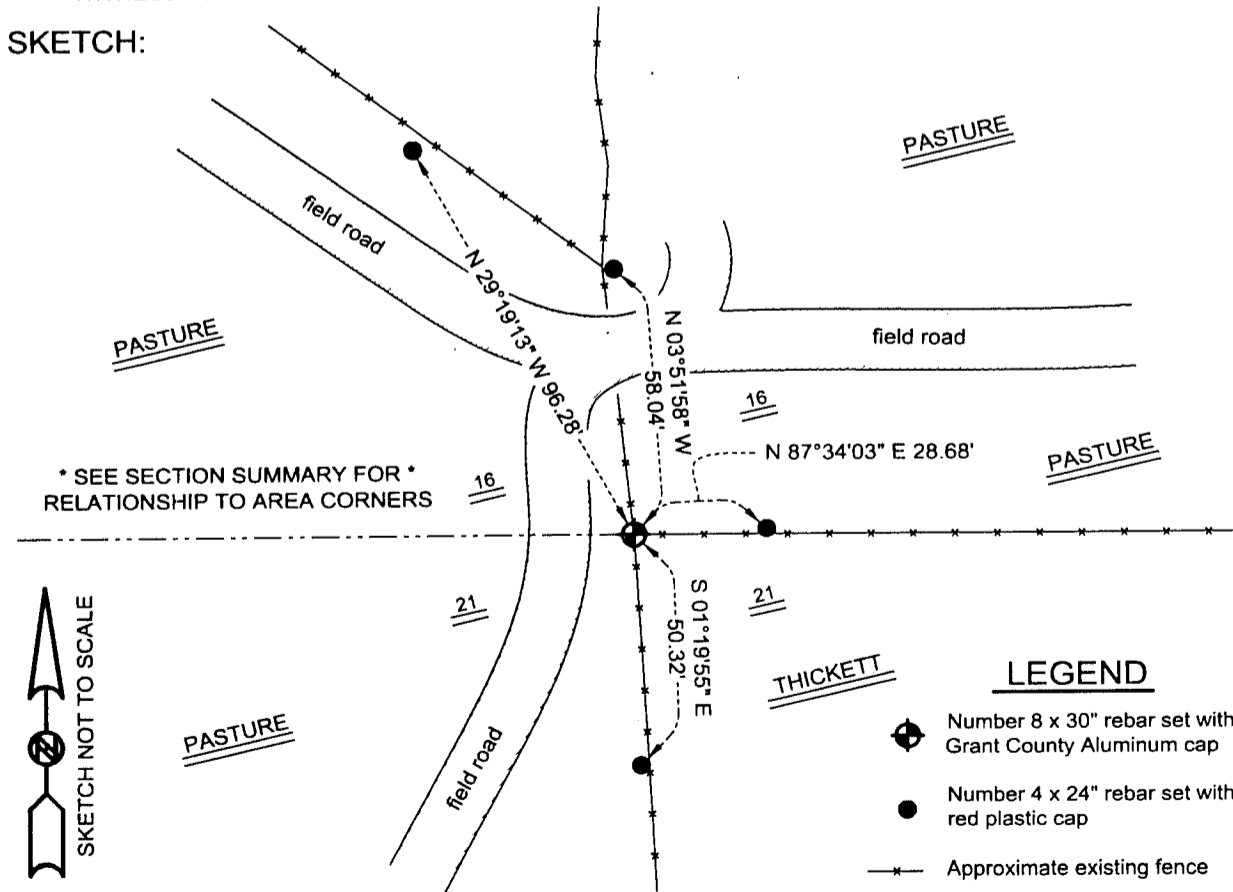

AUSTIN ENGINEERING, LLC
4211 HWY 81 E, LANCASTER, WI 53813
PHONE 608-723-6363 FAX 608-723-6702

FIELDBOOK: SDR33, 2045
G:\T3NR2W\18
C:\SC14\SWA\TIE\T3NR2W\68

DRAWN BY: SW AUSTIN
APPROVED: LL AUSTIN
CREW: BS - SB - SA - TF

JUN 14 2001