

GRANT COUNTY CERTIFIED LAND CORNER

CORNER NUMBER 76

CERTIFICATE:


I, Larry L. Austin, do hereby certify that on the 4th day of January, 2001, I found evidence of the West 1/4 corner of Section 21, Town 3 North, Range 2 West, of the 4th Principal Meridian, and I re-established said corner according to the Wisconsin statutes as shown and described hereon.

Dated this 12th day of February, 2001

Larry L. Austin
Larry L. Austin S-1903



SEAL

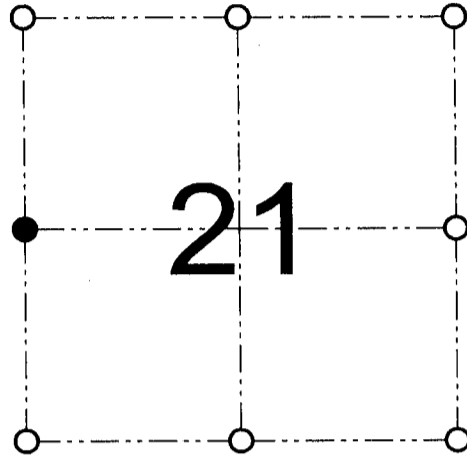

● = CORNER LOCATION

WEST 1/4 CORNER OF
SECTION 21, T 3 N R 2 W
TOWN OF HARRISON

HISTORY OF ORIGINAL CORNER ESTABLISHMENT:

Corner was originally set in 1832 by Robert Clark.
No other record of the corner was found.

DESCRIPTION OF CORNER EVIDENCE FOUND:


I reset the corner at an occupied fence corner. This location fit well with adjoining corners. Verified this location using EDM & GPS methods.

DESCRIPTION OF CORNER AND WITNESS MONUMENTS, references and accessories used to perpetuate the original or re-established location of this corner

WITNESS TO THE CORNER LOCATION: SHANE AUSTIN & BOBBY SEDGWICK

SKETCH:

LEGEND

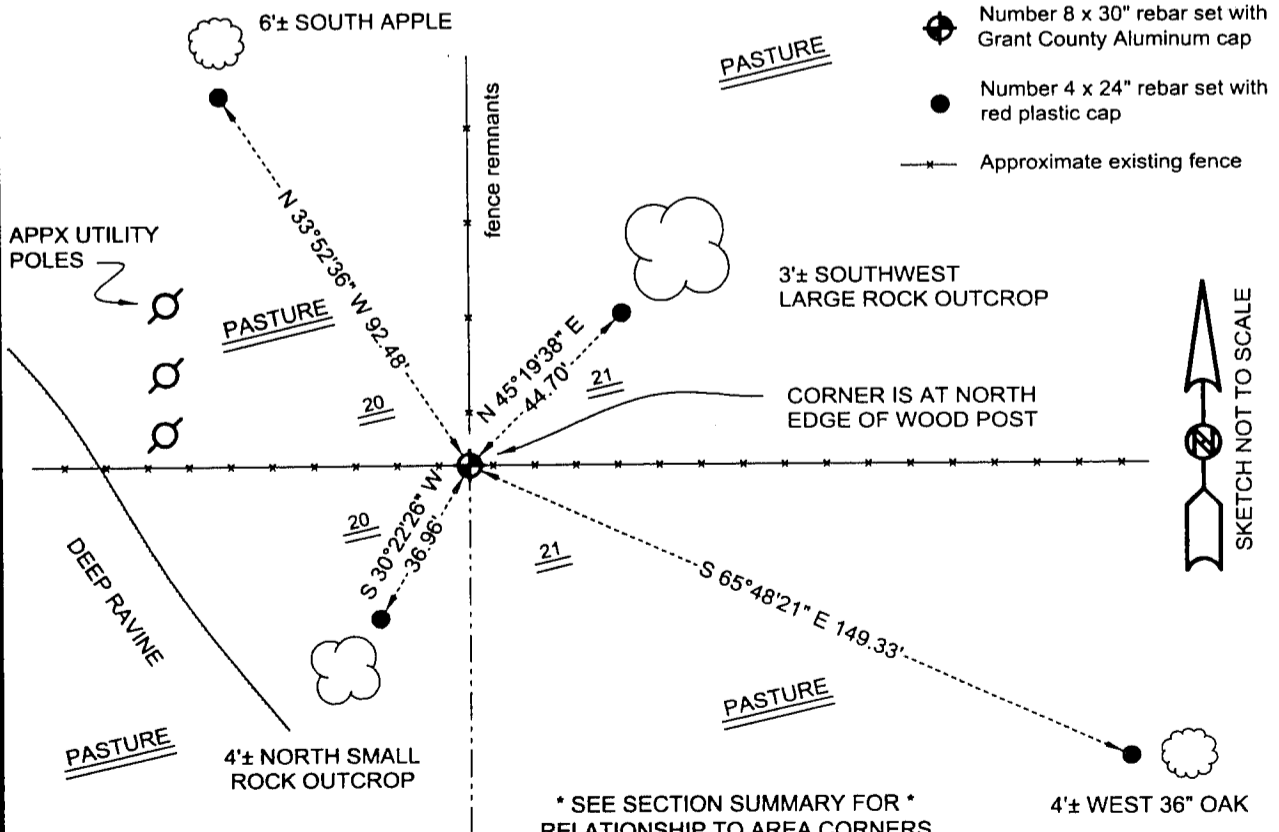

* SEE SECTION SUMMARY FOR *
RELATIONSHIP TO AREA CORNERS

AUSTIN ENGINEERING, LLC
4211 HWY 81 E, LANCASTER, WI 53813
PHONE 608-723-6363 FAX 608-723-6702

FIELDBOOK: SDR33, 20-45
G:\T3NR2W\18
C:\SC14\SWA\TIE\T3NR2W\18

DRAWN BY: SW AUSTIN
APPROVED: LL AUSTIN
CREW: BS - SB - SA - TF

JUN 14 2001