

GRANT COUNTY CERTIFIED LAND CORNER

CORNER NUMBER 80


CERTIFICATE:

I, Larry L. Austin, do hereby certify that on the 12th day of September, 2000, I found evidence of the East 1/4 corner of Section 24, Town 3 North, Range 2 West, of the 4th Principal Meridian, and I re-established said corner according to the Wisconsin statutes as shown and described hereon.

Dated this 8th day of November, 2000

Larry L. Austin
 Larry L. Austin S-1903
 Grant County Clerk

N 476369.5
 E 863747.6

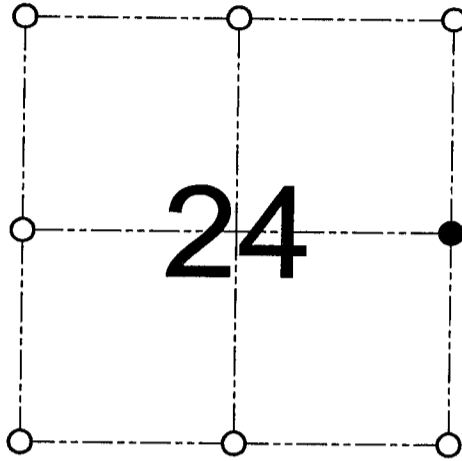

● = CORNER LOCATION
 EAST 1/4 CORNER OF SECTION 24, T 3 N R 2 W TOWN OF HARRISON

HISTORY OF ORIGINAL CORNER ESTABLISHMENT:

Corner was originally set in 1832 by Lucius Lyon.
 In 1897 Sampson tied to the corner.

DESCRIPTION OF CORNER EVIDENCE FOUND:

I found the existing West Quarter corner of Section 19 and set the corner at the proportioned offset from that corner. Verified it's location using EDM & GPS methods.

DESCRIPTION OF CORNER AND WITNESS MONUMENTS, references and accessories used to perpetuate the original or re-established location of this corner

WITNESS TO THE CORNER LOCATION: SHANE AUSTIN & JASON MILES & BOBBY SEDGWICK

SKETCH:

