


Survey Monument Record

TYPE OF MONUMENT 3/4" X 24" IRON BAR
SET

CORNER NO. 97
SECTION 28
TOWN 3N
RANGE 2W

FIELD BOOK: 97-04(A)
PAGE (3)

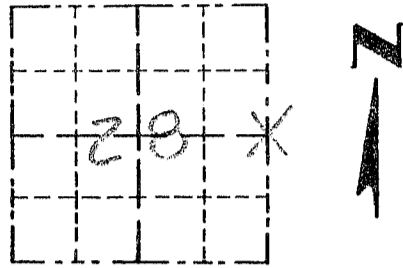

LOCATION
(Indicated by "X")


BASIS FOR MONUMENT LOCATION

(Use reverse side if necessary)

Show info such as: History of corner, with reference to Vol. and pg., dates, surveyor; exact description of monument replaced; if location computed, by taped or EDM traverse; landowner, remarks, etc.

CORNER SET IN 1833 BY ROBERT CLARK; OVERTON, Co. SURVEYOR WAS AT THE CORNER IN 1855. CORNER WAS SET AT AN OCCUPIED FENCE CORNER, VERIFIED THIS LOCATION USING EDM METHODS.

SEAL:

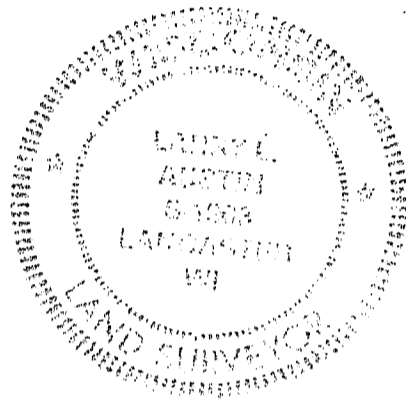

CERTIFIED CORRECT

Larry L. Adstun
Registered Land Surveyor

DATE: 12/31/97

TIE SKETCH

Show at least three (3) ties and monument

