


GRANT COUNTY

Survey Monument Record

TYPE OF MONUMENT Alum. MONUMENT
STATE PLANE COORDINATES: N _____
E _____
ELEVATION — M.S.L. DATUM: _____
THETA ANGLE: _____
FIELD BOOK: 9320
PAGE _____

CORNER NO. _____
SECTION 5
TOWN 2N
RANGE 2W

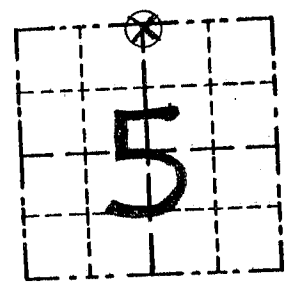


BASIS FOR MONUMENT LOCATION

(Use reverse side if necessary)
Show info such as: History of corner, with reference to Vol. and pg., dates, surveyor; exact description of monument replaced; if location computed, by taped or EDM traverse; landowner, remarks, etc.

NO RECORD OF CORNER FOUND SINCE ORIG. SURVEYS. MONUMENT WAS SET AT OCCUPIED LOCATION & VERIFIED BY EDM TRAVERSE.

LOCATION
(Indicated by 'X')
N¹/₄ COR, SEC 5, T2N, R2W
SEAL:

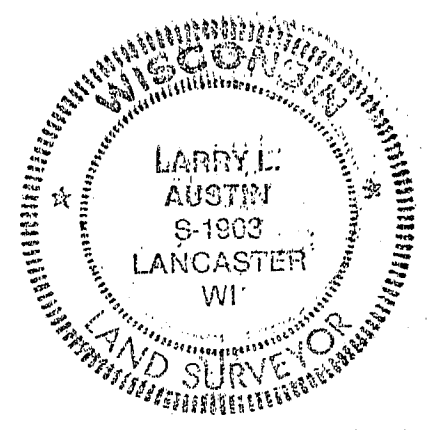


CERTIFIED CORRECT
Larry L. Austin
Registered Land Surveyor
DATE: 12/9/93

TIE SKETCH

Show at least three (3) ties and monument

LEGEND

- Alum Mon.
- 3/8" x 12" STEEL SPIKES
- x—x— FENCE

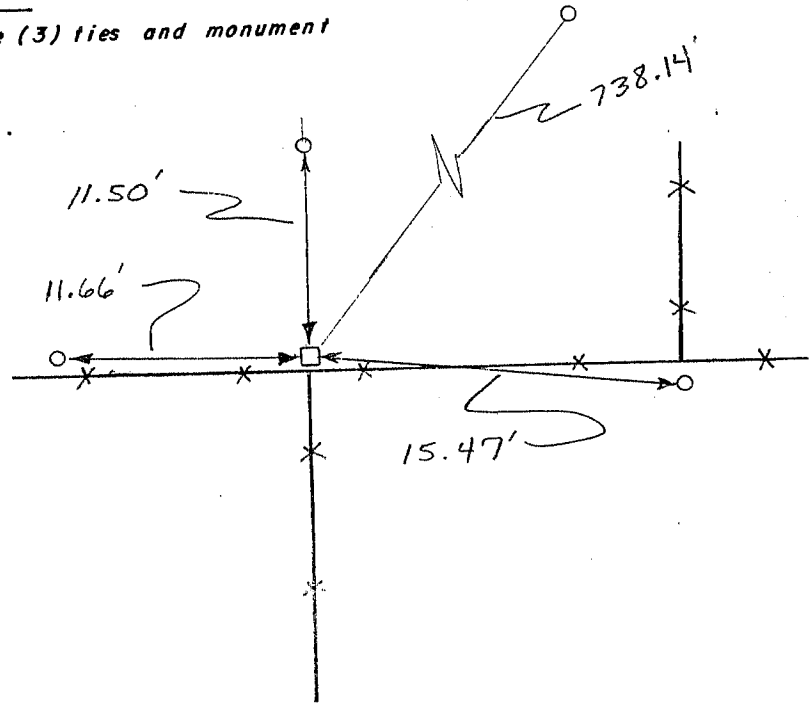

No SCALE