


Survey Monument Record

TYPE OF MONUMENT 3/4" X 24" IRON BAR
SET 6" BELOW GRADE

CORNER NO. 128
 SECTION 33
 TOWN 3N
 RANGE ZW

FIELD BOOK: 97-11
 PAGE (7)

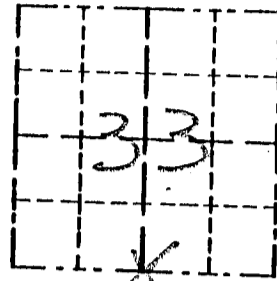


BASIS FOR MONUMENT LOCATION

(Use reverse side if necessary)

Show info such as: History of corner, with reference to Vol. and pg., dates, surveyor; exact description of monument replaced; if location computed, by taped or EDM traverse; landowner, remarks, etc.

LOCATION
 (Indicated by "X")

SEAL:

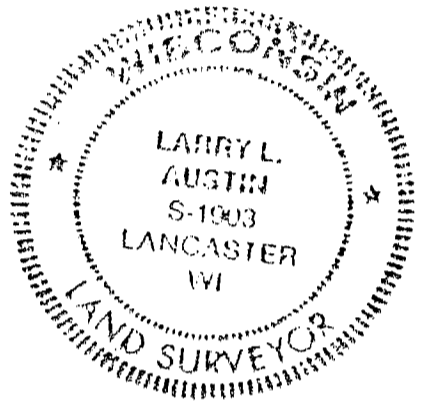

CORNER SET IN 1832 BY LUCIUS LYON. NO RECORD OF CORNER FOUND SINCE ORIGINAL SURVEY; CORNER WAS SET AT OCCUPIED CENTERLINE EAST/WEST AND FENCE SOUTH. NO OFFSETS EAST OR WEST OF CORNER. VERIFIED ITS LOCATION USING EDM METHODS.

CERTIFIED CORRECT

Larry L. Austin
 Registered Land Surveyor

DATE: 7-30-97

TIE SKETCH

Show at least three (3) ties and monument

LEGEND

- ⊕ 3/4" X 24" IRON BAR SET
- 1/2" X 15" IRON BAR SET
- XX EXISTING FENCE

