


Survey Monument Record

TYPE OF MONUMENT 3/4" x 24" IRON  
BAR SET W/ CAP

CORNER NO. 18  
 SECTION 02  
 TOWN 3N  
 RANGE 3W

FIELD BOOK: 96-01  
 PAGE 25

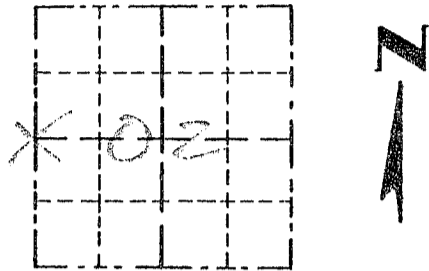

LOCATION  
 (Indicated by "X")


BASIS FOR MONUMENT LOCATION

(Use reverse side if necessary)

Show info such as: History of corner, with reference to Vol. and pg., dates, surveyor; exact description of monument replaced; if location computed, by taped or EDM traverse; landowner, remarks, etc.

SEAL:

CORNER SET IN 1933 BY ROBERT CLARK. NO RECORD OF CORNER FOUND SINCE ORIGINAL SURVEYS. I SET THE CORNER ONLINE BETWEEN THE NW AND SW CORNERS, ALSO ONLINE W/ A FENCE TO THE WEST. VERIFIED THIS LOCATION USING EDM METHODS.

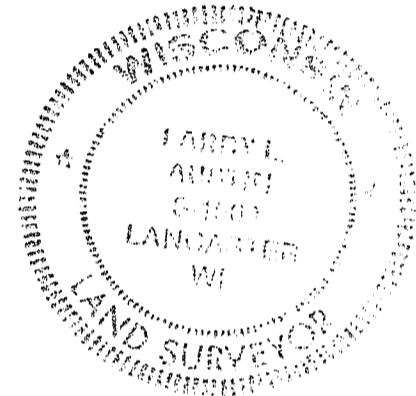

CERTIFIED CORRECT

*David L. Anton*  
 Registered Land Surveyor

DATE: 12-20-97

TIE SKETCH

Show at least three (3) ties and monument

LEGEND

- ⊕ 3/4" x 24" IRON BAR SET W/ CAP.
- 1/2" x 15" IRON BAR SET
- xx EXISTING FENCE

