


U. S. PUBLIC LAND SURVEY MONUMENT RECORD

INSTRUCTIONS: This record shall show the location of the corner and shall include all of the following nine elements (a through i).

- (a) Identify the corner by reference to the U.S. public land survey system.
 ○ = Corner monument restored.

Northeast Corner, Section 20
 Town 3 North, Range 3 West

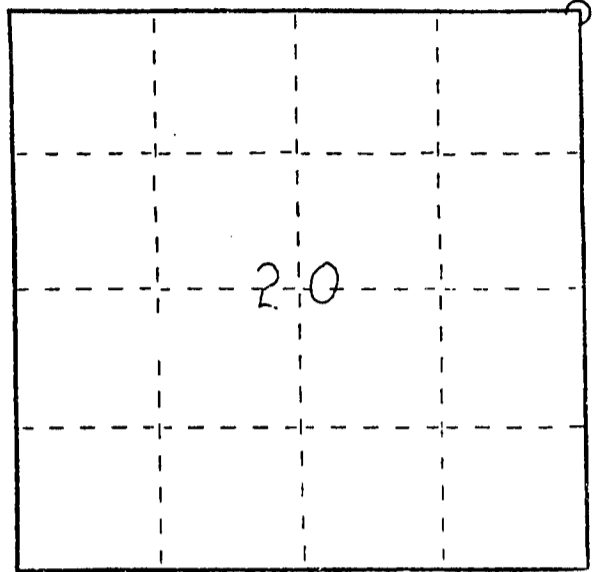


- (b) Describe any record evidence, monument evidence, occupational evidence, testimonial evidence or any other material evidence you considered, and whether the monument was found or placed.

The closest corner tie on file to said corner is the northeast corner of Section 20 showing the corner to be at the centerline of Brovillard Hill Road. In 1910 a brick was supposedly set according to Book D, page 331 of Grant County Survey Records. Also in the records, a survey was mentioned having a bearing reference in the SW 1/4 of Section 16 dated May 25, 1973 by Homer Ralph, Jr. We found a durable iron bar about 1 foot beneath the present top of Brovillard Hill Road in the approximate centerline, on line with an existing fenceline to the north and accepted as is. The corner measures 2643.3' +/- to a 24" cedar tree at the north 1/4 corner of 20.

- (c) In the plan view drawing below, provide reference ties to at least 4 witness monuments, or, if the location is within a municipality, to at least 2 witness monuments. (Witness monuments shall be made of concrete, natural stone, iron or other equally durable material.) Describe witness monuments.

- (d) Show a plan view drawing depicting the relevant monuments and reference ties which is sufficient in detail to enable accurate relocation of the corner monument if the corner monument is disturbed. Indicate north.

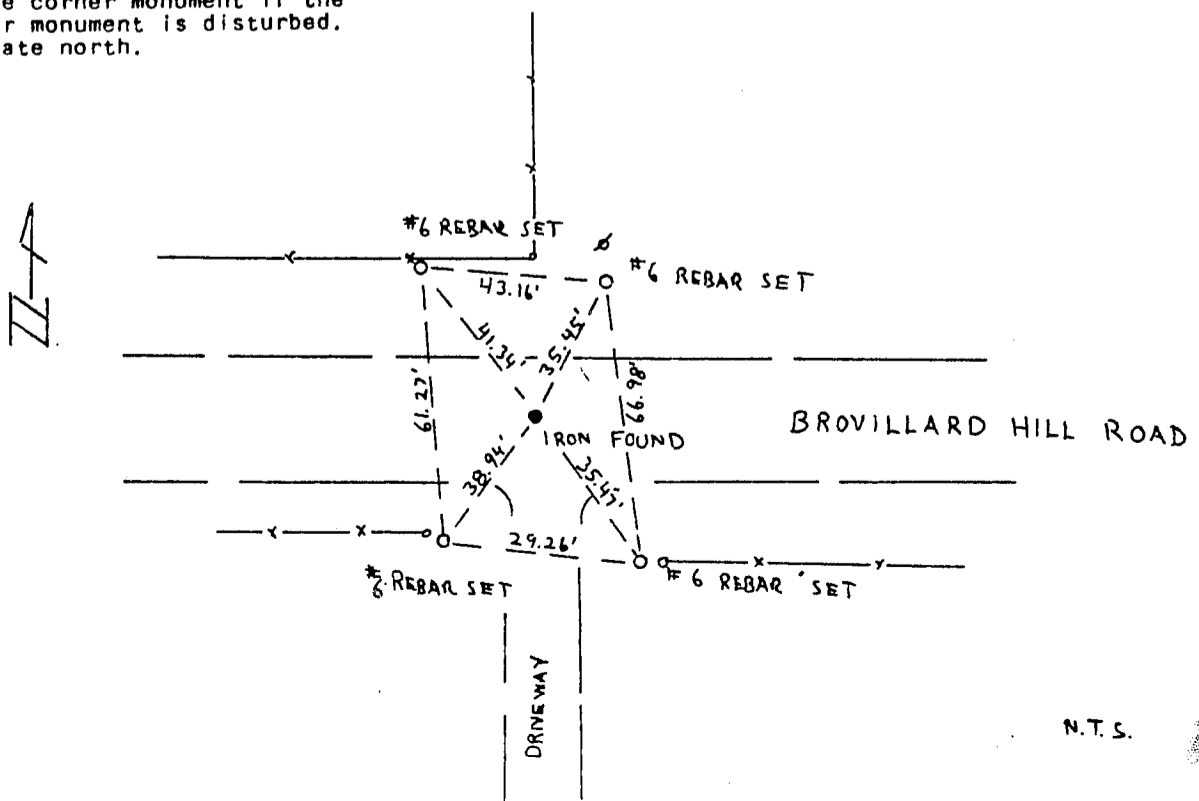

N.T.S.

P. 69

(e) Describe any material discrepancy between the location of the corner as restored or reestablished and the location of that corner as previously restored or reestablished by distance and direction. Show the discrepancy on the plan view drawing under (d), above. Show the distances between the corner as previously restored or reestablished and (1) the corner as restored or reestablished, and (2) to at least 2 of the witness monuments shown on the drawing in (d), above.

None Available.

(f) Was the corner restored through acceptance of (1) an obliterated evidence location, or, (2) a found perpetuated location?

(2) Found perpetuated location (corner monument found not shown on any survey of record, but fits existing topography well).

(g&h) Was the corner reestablished through lost corner proportionate methods? If so, show the method, including the directions and distances to other public land survey corners used as evidence or used for proportioning in determining the corner location?

(1) I, Terrance L. Genske
(type or print name) certify that the corner location shown on this record was determined by me or under my direction and control and that this U.S. Public Land Survey Monument Record is correct and complete to the best of my knowledge and belief.

Terrance L. Genske

2/28/84

BARRIENTOS & ASSOC., INC.

