

GRANT COUNTY

REC'D MAR 8 1996

Survey Monument Record

TYPE OF MONUMENT COUNTY MONUMENT

STATE PLANE COORDINATES: N _____
E _____


ELEVATION — M.S.L. DATUM: _____

THETA ANGLE: _____

FIELD BOOK: 9503

PAGE 27

CORNER NO. 89
SECTION 29
TOWN 3 N
RANGE 3 W

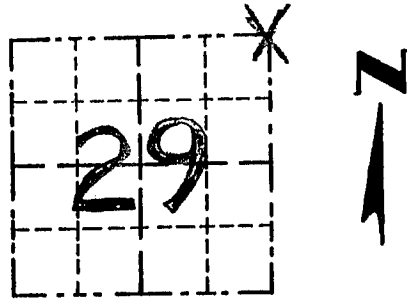


LOCATION
(Indicated by "X")

BASIS FOR MONUMENT LOCATION

(Use reverse side if necessary)

Show info such as: History of corner, with reference to Vol. and pg., dates, surveyor; exact description of monument replaced; if location computed, by taped or EDM traverse; landowner, remarks, etc.

SEAL:

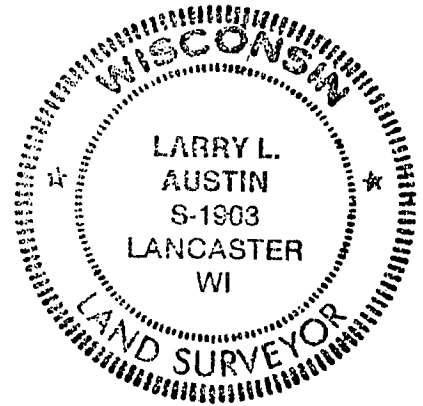

ORIGINAL CORNER SET IN
1833 BY CLARK.

CORNER WAS RESET AT OCCUPIED
FENCE CORNER AND VERIFIED
BY EDM TRAVERSE OF THE
AREA.

CERTIFIED CORRECT

Larry L. Austin
Registered Land Surveyor

DATE: 2/1/96

TIE SKETCH

Show at least three (3) ties and monument

* ALL TIES = 1" x 12" IRON *
PIPES SET

