

REC'D MAY 7 1996

Survey Monument Record

TYPE OF MONUMENT GRANT CO. Alum. Mon.

STATE PLANE COORDINATES: N _____
E _____


ELEVATION — M.S.L. DATUM: _____

THETA ANGLE: _____

FIELD BOOK: 9105

PAGE 18

CORNER NO. 102
SECTION 36
TOWN 3N
RANGE 3W
N 1/4 COR

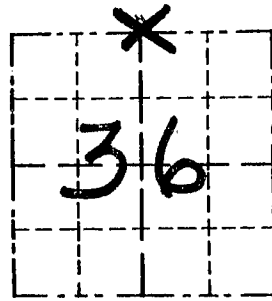

LOCATION
(Indicated by "X")

BASIS FOR MONUMENT LOCATION

(Use reverse side if necessary)

ORIGINAL CORNER SET
1833 BY ROBERT
CLARK; NO RECORD FOUND
OF CORNER SINCE ORIGINAL
SURVEY. A NORTH-SOUTH FENCE
WAS USED FOR E-W LOCATION
AND A FENCE RUNNING EAST
WAS ACCEPTED FOR N-S LOCATION.

SEAL:



ALUMINUM MONUMENT WAS PLACED
AFTER VERIFICATION BY EDM
TRAVERSE OF THE AREA.

CERTIFIED CORRECT

Larry L. Austin
Registered Land Surveyor

DATE: 3-1-96

TIE SKETCH

Show at least three (3) ties and monument

LEGEND

- ⊕ GRANT COUNTY ALUMINUM MONUMENT SET
- 3/8" x 12" IRON SPIKES SET FLUSH = TIES
- * * * EXISTING FENCE

