


Survey Monument Record

TYPE OF MONUMENT 1" X 15" IRON BAR  
FOUND

CORNER NO. 111  
 SECTION 30  
 TOWN 3N  
 RANGE 4W

FIELD BOOK: 96-03  
 PAGE (32)

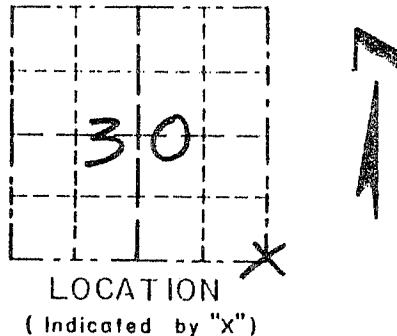


BASIS FOR MONUMENT LOCATION

(Use reverse side if necessary)

Show info such as: History of corner, with reference to Vol. and pg, dates, surveyor; exact description of monument replaced; if location computed, by taped or EDM traverse; landowner, remarks, etc.

SEAL:

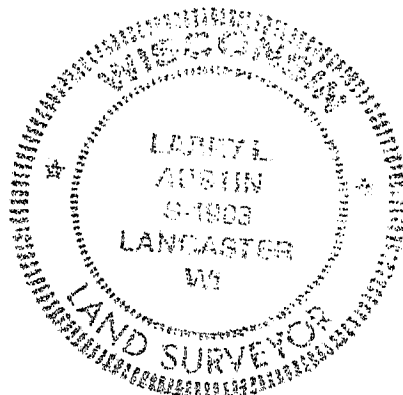

CORNER SET IN 1833 BY LUCIUS LYON. IN 1980 BRUCE BOWDEN SET A 1" X 15" IRON BAR AT CORNER. I FOUND AND ACCEPTED ITS LOCATION AFTER EDM TRAVERSE OF AREA.

CERTIFIED CORRECT

*Larry L. Adstin*  
 Registered Land Surveyor  
 DATE: 1-16-98

TIE SKETCH

Show at least three (3) ties and monument

LEGEND

- ⊕ 1" X 15" IRON BAR FOUND
- 1/2" X 15" IRON BAR SET
- EXISTING FENCE
- 3/4" X 24" IRON BAR SET

