

GRANT COUNTY CERTIFIED LAND CORNER

CORNER NUMBER 67

CERTIFICATE:


I, Larry L. Austin, do hereby certify that on the 25th day of May, 2000, I found evidence of the Northeast corner of Section 21, Town 3 North, Range 5 West, of the 4th Principal Meridian, and I re-established said corner according to the Wisconsin statutes as shown and described hereon.

Dated this 15th day of July, 2000

Larry L. Austin
Larry L. Austin 5-1903



SEAL

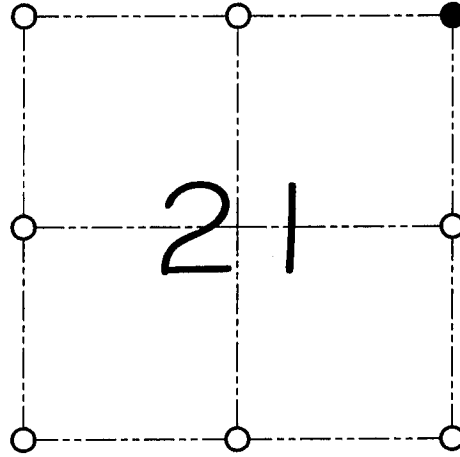

● = CORNER LOCATION

NORTHEAST CORNER OF
SECTION 21, T 3 N R 5 W
TOWN OF CASSVILLE

HISTORY OF ORIGINAL CORNER ESTABLISHMENT:

Corner was originally set in 1833 by Lucius Lyon.
In 1978 Kenneth Kerst set a 2" iron pipe at this location.

DESCRIPTION OF CORNER EVIDENCE FOUND:

The 2" iron pipe was lost during road construction.
I reset the corner based on measurements to area Kerst surveys.
Verified this location using E.D.M. & G.P.S. methods.

DESCRIPTION OF CORNER AND WITNESS MONUMENTS, references and accessories used to perpetuate the original or re-established location of this corner

WITNESS TO THE CORNER LOCATION: SHELBY BLINDERT & BOBBY SEDGWICK

SKETCH:

