


Survey Monument Record

TYPE OF MONUMENT 3/4" x 24"
REBAR SET

CORNER NO. _____
 SECTION 27
 TOWN 3N
 RANGE 5W

FIELD BOOK: 97-36
 PAGE _____

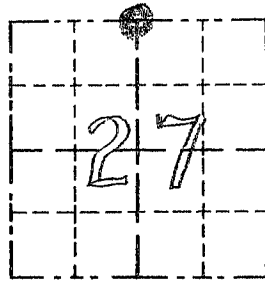

LOCATION
 (Indicated by "X")


BASIS FOR MONUMENT LOCATION

(Use reverse side if necessary)

Show info such as: History of corner, with reference to Vol. and pg., dates, surveyor; exact description of monument replaced; if location computed, by taped or EDM traverse; landowner, remarks, etc.

CORNER WAS SET IN 1833 BY LUCIUS LYON; NO RECORD OF THE CORNER FOUND SINCE THE ORIGINAL SURVEYS. I SET THE CORNER AT AN OCCURATIONAL EVIDENCE LOCATION AFTER VERIFICATION BY EDM TRAVERSE OF THE AREA.

SEAL:

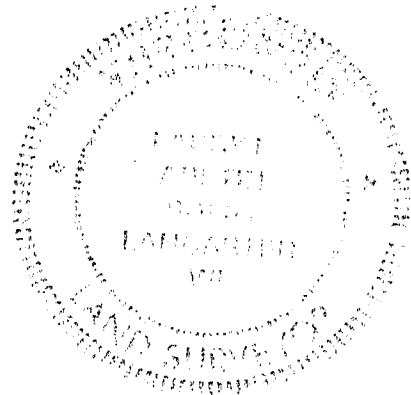


CERTIFIED CORRECT

Henry L. Christ
 Registered Land Surveyor

DATE: 1-21-98

TIE SKETCH

Show at least three (3) ties and monument

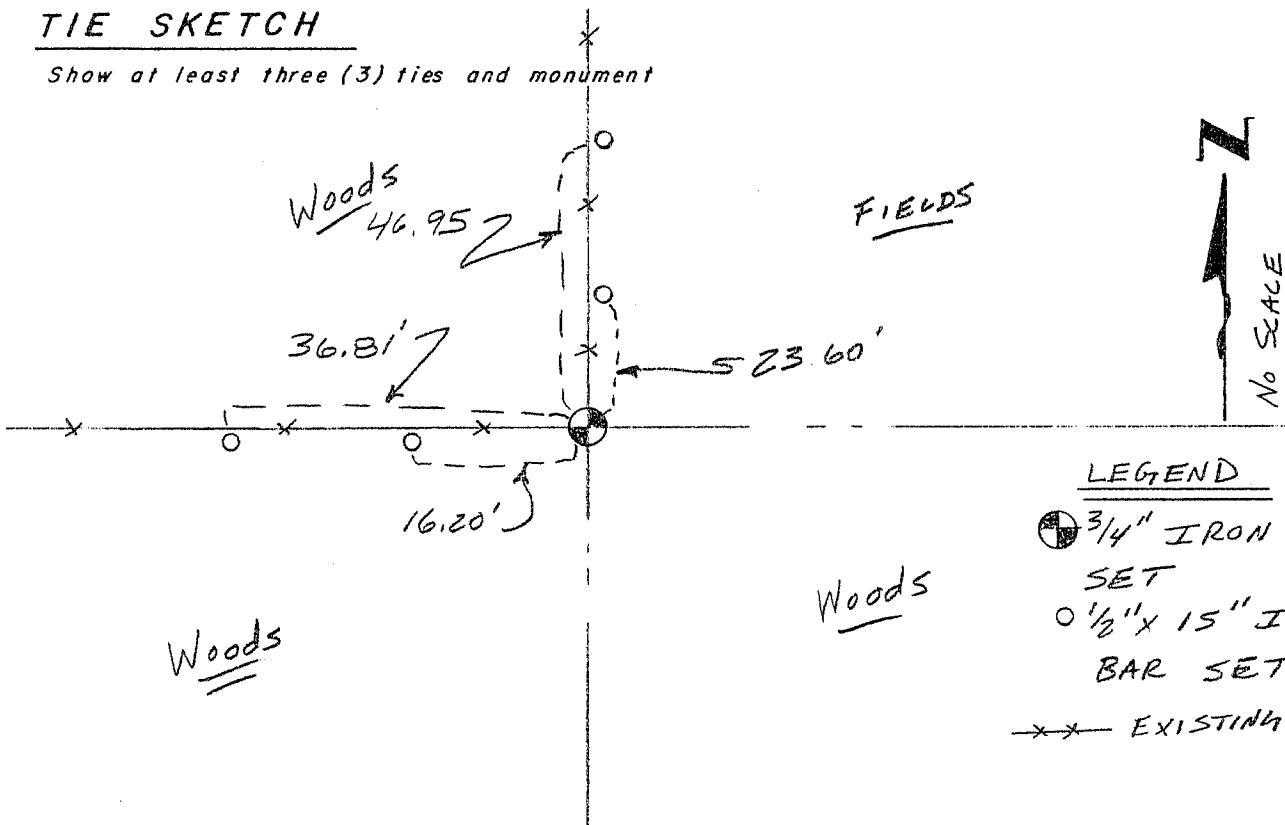

LEGEND

- 3/4" IRON BAR SET
- 1/2" x 15" IRON BAR SET
- EXISTING FENCE