

GRANT COUNTY CERTIFIED LAND CORNER


CORNER NUMBER 106

CERTIFICATE:

I, Larry L. Austin, do hereby certify that on the 10th day of July, 2000, I found evidence of the South 1/4 corner of Section 27, Town 3 North, Range 5 West, of the 4th Principal Meridian, and I re-established said corner according to the Wisconsin statutes as shown and described hereon.

Dated this 28th day of July, 2000

Larry L. Austin
Larry L. Austin S-1903

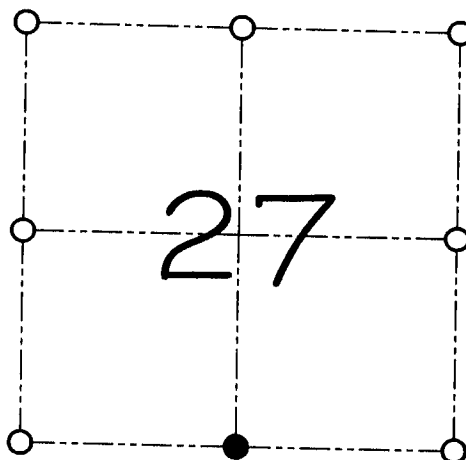

● = CORNER LOCATION

SOUTH 1/4 CORNER OF
SECTION 27, T 3 N R 5 W
TOWN OF CASSVILLE

HISTORY OF ORIGINAL CORNER ESTABLISHMENT:

Corner was never originally set.
In 1983 Janiak set a 1" iron pipe at this location.

DESCRIPTION OF CORNER EVIDENCE FOUND:

I found the existing 1" iron pipe and accepted it's location after an EDM & GPS traverse of the area.

DESCRIPTION OF CORNER AND WITNESS MONUMENTS, references and accessories used to perpetuate the original or re-established location of this corner

WITNESS TO THE CORNER LOCATION: LAUREN SAWDY & BOBBY SEDGWICK

SKETCH:

