


# GRANT COUNTY

## Survey Monument Record

TYPE OF MONUMENT COUNTY MONUMENT  
 STATE PLANE COORDINATES: N \_\_\_\_\_  
 E \_\_\_\_\_  
 ELEVATION — M.S.L. DATUM: \_\_\_\_\_  
 THETA ANGLE: \_\_\_\_\_  
 FIELD BOOK: 9506  
 PAGE: 23

CORNER NO. 98  
 SECTION 27  
 TOWN 3 N  
 RANGE 5 W  
E 1/4 COR

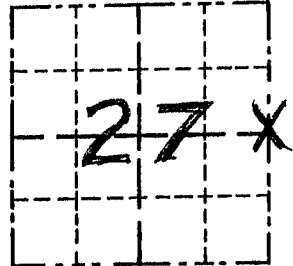

LOCATION  
(Indicated by "X")


### BASIS FOR MONUMENT LOCATION

(Use reverse side if necessary)

Show info such as: History of corner, with reference to Vol. and pg., dates, surveyor; exact description of monument replaced; if location computed, by taped or EDM traverse; landowner, remarks, etc.

CORNER WAS ORIGINALLY SET IN 1833 BY LUCIUS LYON; NO RECORD FOUND OF CORNER SINCE ORIG. SURVEYS; ACCEPTED OCCUPATION LOCATION AFTER VERIFICATION BY EDM TRAVERSE IN THE AREA.

SEAL:

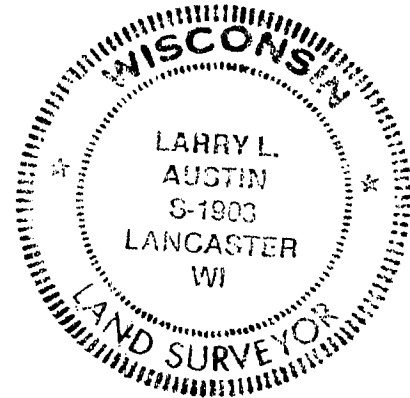

CERTIFIED CORRECT

*Larry L. Austin*  
 Registered Land Surveyor

DATE: 6/30/95

### TIE SKETCH

Show at least three (3) ties and monument

#### LEGEND

- ⊕ GRANT Co. Alum. MONUMENT SET
- 1" x 12" MIN. IRON PIPES SET = TIES
- X — EXISTING FENCE

