


Survey Monument Record

TYPE OF MONUMENT 3/4" X 24" IRON BAR  
SET

CORNER NO. 15  
 SECTION 06  
 TOWN 3N  
 RANGE 10W

FIELD BOOK: 96-08  
 PAGE (18)

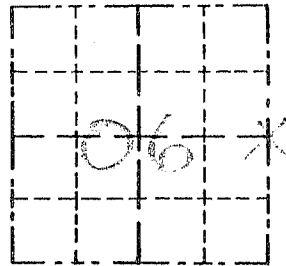

LOCATION  
 (Indicated by "X")


BASIS FOR MONUMENT LOCATION

(Use reverse side if necessary)

Show info such as: History of corner, with reference to Vol. and pg., dates, surveyor; exact description of monument replaced; if location computed, by taped or EDM traverse; landowner, remarks, etc.

CORNER SET IN 1833 BY ROBERT CLARK. IN 1876 JOEL BARBER MEASURED TO THE CORNER NO MONUMENT PLACED. I FOUND AN ORIGINAL BEARING TREE. THE DISTANCE TO THE BEARING TREE IS VERIFIED BY OCCUPATION FENCE TO THE EAST. I ACCEPTED THIS LOCATION AFTER VERIFICATION BY EDM TRAVERSE OF THE AREA.

SEAL:

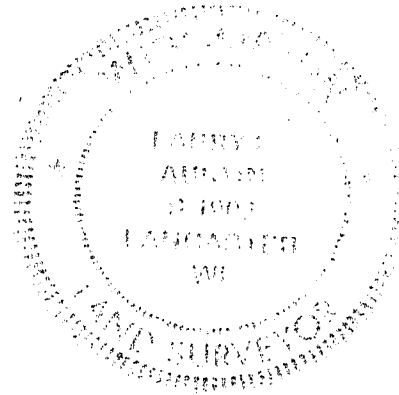

CERTIFIED CORRECT

*Henry L. Rust*  
 Registered Land Surveyor

DATE: 1-16-98

TIE SKETCH

Show at least three (3) ties and monument

LEGEND

- ⊙ 3/4" X 24" IRON BAR SET
- 1/2" X 15" IRON BAR SET
- \*\* EXISTING FENCE

