

GRANT COUNTY

Survey Monument Record

TYPE OF MONUMENT GRANT COUNTY ALUMINUM MON

STATE PLANE COORDINATES: N
E

ELEVATION — M.S.L. DATUM:

THETA ANGLE:

FIELD BOOK:

PAGE


CORNER NO. 45

SECTION 11

TOWN 4N

RANGE 1W

SW CORNER

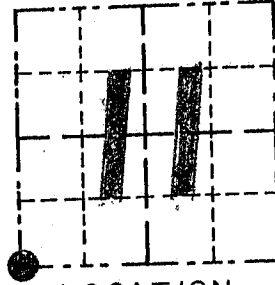

LOCATION
(Indicated by "●")




BASIS FOR MONUMENT LOCATION

(Use reverse side if necessary)

Show info such as: History of corner, with reference to Vol. and pg. dates, surveyor; exact description of monument replaced; if location computed, by taped or EDM traverse; landowner, remarks, etc.

SEAL:

NO RECORD OF CORNER FOUND
SINCE ORIGINAL SURVEYS; ACCEPTED
N-S FENCE FOR E-W LOCATION,
& PROJECTION OF WATERFALL ROAD
FOR N-S LOCATION VERIFIED THIS
LOCATION BY EDM TRAVERSE OF
THE AREA.

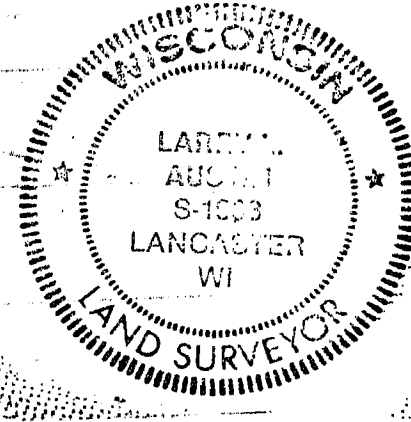

CERTIFIED CORRECT

Larry L. August
Registered Land Surveyor

DATE: 10/6/94

TIE SKETCH

Show at least three (3) ties and monument

