


GRANT COUNTY

Survey Monument Record

GRANT Co.
 TYPE OF MONUMENT ALUMINUM MONUMENT
 STATE PLANE COORDINATES: N _____
 E _____
 ELEVATION — M.S.L. DATUM: _____
 THETA ANGLE: _____
 FIELD BOOK: NA
 PAGE: NA

CORNER NO. 39.38
 SECTION 11
 TOWN 4 N
 RANGE 1 W
W 1/4 COR.

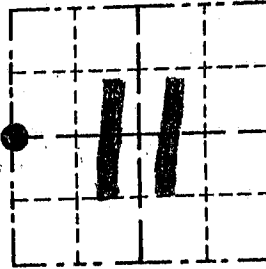


LOCATION
 (Indicated by "•")

BASIS FOR MONUMENT LOCATION

(Use reverse side if necessary)
 Show info such as: History of corner, with reference to Vol. and pg., dates, surveyor; exact description of monument replaced; if location computed, by taped or EDM traverse; landowner, remarks, etc.

SEAL:

No RECORD OF CORNER SINCE ORIGINAL SURVEYS; CORNER IS AT ACCEPTED OCCUPATION CORNER & VERIFIED BY EDM TRAVERSE OF THE AREA

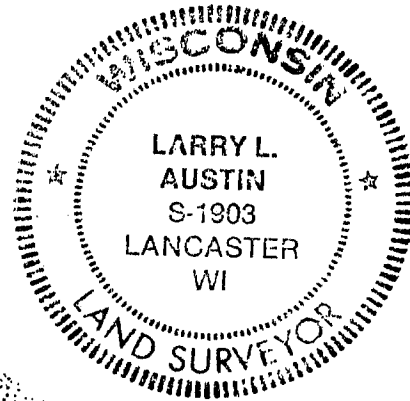

CERTIFIED CORRECT

Larry L. Austin
 Registered Land Surveyor
 DATE: 9/20/94

TIE SKETCH

Show at least three (3) ties and monument

