


Survey Monument Record

TYPE OF MONUMENT 3/4" X 24" IRON  
BAR SET

CORNER NO. 91  
SECTION 19  
TOWN 4N  
RANGE 1W

FIELD BOOK: 96-22(A)  
PAGE 23

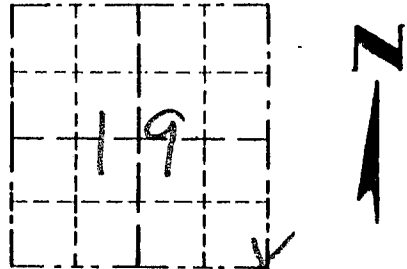

LOCATION  
(Indicated by "X")


BASIS FOR MONUMENT LOCATION

(Use reverse side if necessary)

Show info such as: History of corner, with reference to Vol. and pg., dates, surveyor; exact description of monument replaced; if location computed, by taped or EDM traverse; landowner, remarks, etc.

SEAL:

CORNER SET IN 1833 BY ROBERT CLARK. NO RECORD OF CORNER FOUND SINCE ORIGINAL SURVEY. CORNER WAS SET IN THE CENTERLINE OF A ROAD FOR EASTING. NORTHING WAS SET BY AN EXISTING FENCE WEST. VERIFIED THIS LOCATION USING EDM METHODS.

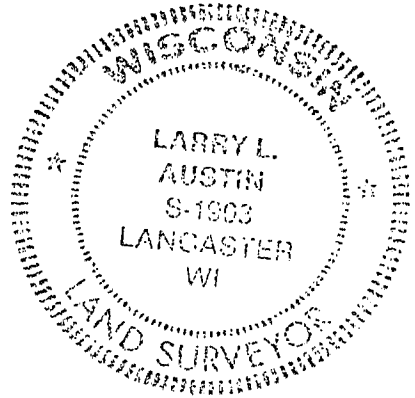

CERTIFIED CORRECT

*Larry L. Austin*  
Registered Land Surveyor

DATE: 2-18-98

TIE SKETCH

Show at least three (3) ties and monument

LEGEND

- ⊕ 3/4" X 24" IRON BAR SET
- 1/2" X 15" IRON BAR SET
- XX EXISTING FENCE

