

Survey Monument Record

TYPE OF MONUMENT 3/4" X 24" IRON BAR SET


CORNER NO. 21
 SECTION 17
 TOWN 4N
 RANGE 1W

FIELD BOOK: 96-22(A)
 PAGE (23)

BASIS FOR MONUMENT LOCATION

(Use reverse side if necessary)


Show info such as: History of corner, with reference to Vol and pg, dates, surveyor; exact description of monument replaced; if location computed, by taped or EDM traverse; landowner, remarks, etc.

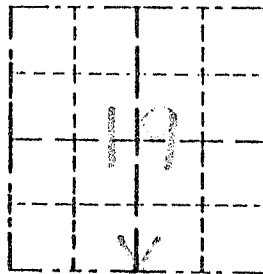

LOCATION
(Indicated by "X")



SEAL:

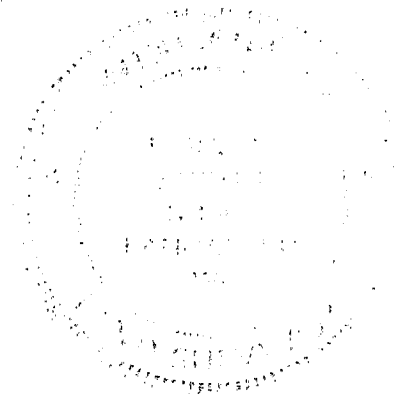

CERTIFIED CORRECT

Henry J. Christ
 Registered Land Surveyor

DATE: 12-15-97

TIE SKETCH

Show at least three (3) ties and monument

LEGEND

- ⊙ 3/4" X 24" IRON BAR SET
- 1/2" X 15" IRON BAR SET
- - - EXISTING FENCE

