


GRANT COUNTY

Survey Monument Record

TYPE OF MONUMENT 3/4" x 24 RD. IRON BAR
 STATE PLANE COORDINATES: N -
 E -
 ELEVATION — M.S.L. DATUM: -
 THETA ANGLE: -
 FIELD BOOK: 95-14
 PAGE 13

CORNER NO. 85
 SECTION 26
 TOWN 4 N
 RANGE 1 W
NW COR.

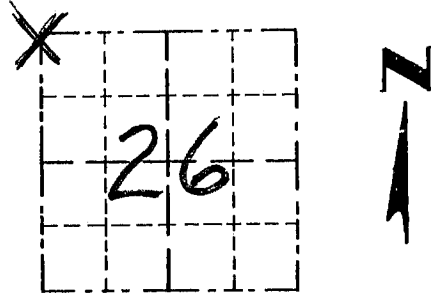

LOCATION
(Indicated by "X")


BASIS FOR MONUMENT LOCATION

(Use reverse side if necessary)

Show info such as: History of corner, with reference to Vol. and pg., dates, surveyor; exact description of monument replaced; if location computed, by taped or EDM traverse; landowner, remarks, etc.

SEAL:

ORIGINAL CORNER SET IN 1833
 BY CLARK. NO RECORD FOUND
 SINCE ORIGINAL SURVEY, CORNER
 WAS RESET ON-LINE AND
 MIDWAY BETWEEN THE WEST 1/4 COR.
 OF SECTION 26 AND THE WEST 1/4 COR.
 OF SECTION 23 AND VERIFIED
 BY EDM TRAVERSE OF THE AREA.

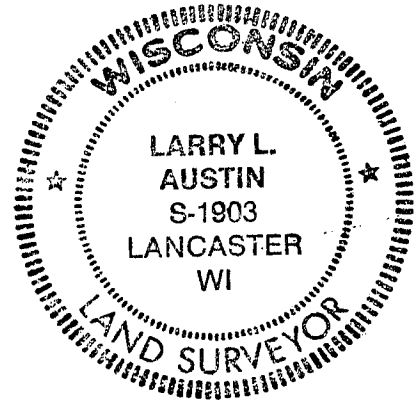

CERTIFIED CORRECT

Larry L. Austin
 Registered Land Surveyor

DATE: 10/20/95

TIE SKETCH

Show at least three (3) ties and monument

