


GRANT COUNTY

Survey Monument Record

TYPE OF MONUMENT 3/4" x 24" IRON BAR SET
 STATE PLANE COORDINATES: N _____
 E _____
 ELEVATION — M.S.L. DATUM: _____
 THETA ANGLE: _____
 FIELD BOOK: 95-14
 PAGE 13

CORNER NO. 78
 SECTION 23
 TOWN 4N
 RANGE 1W
W 1/4 COR

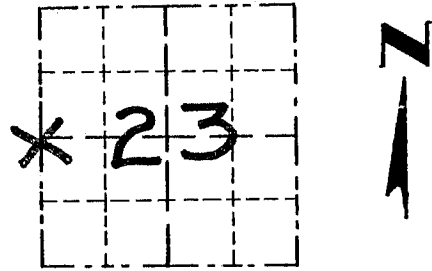

LOCATION
(Indicated by "X")


BASIS FOR MONUMENT LOCATION

(Use reverse side if necessary)

Show info such as: History of corner, with reference to Vol. and pg., dates, surveyor; exact description of monument replaced; if location computed, by taped or EDM traverse; landowner, remarks, etc.

SEAL:

CORNER ORIGINALLY SET IN 1833 BY CLARK. NO RECORD FOUND SINCE ORIGINAL SURVEY. CORNER WAS SET. CORNER WAS REESTABLISHED BY OCCUPATIONAL EVIDENCE OF THE ROAD NORTH-SOUTH AND EXISTING FENCE EAST-WEST AND VERIFIED BY EDM TRAVERSE OF THE AREA.

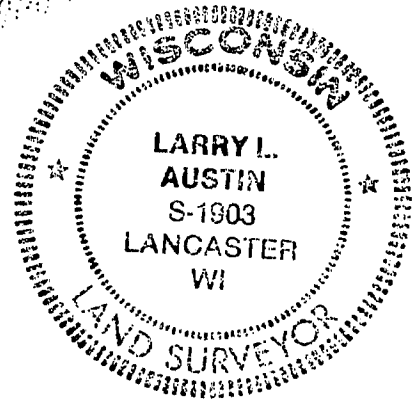

CERTIFIED CORRECT

Larry L. Austin
 Registered Land Surveyor

DATE: 10/20/95

TIE SKETCH

Show at least three (3) ties and monument

LEGEND

⊕ 3/4" x 24" IRON BAR SET

○ 1" x 12" IRON PIPES SET

—x—x— EXISTING FENCE

